


# Farmers Irrigation District Spray Use Permit 39822

Townships 2 and 3 North, Range 10 East, W.M.




## Permits

 39822

## FINAL PROOF MAP

1 inch = 1,320 feet

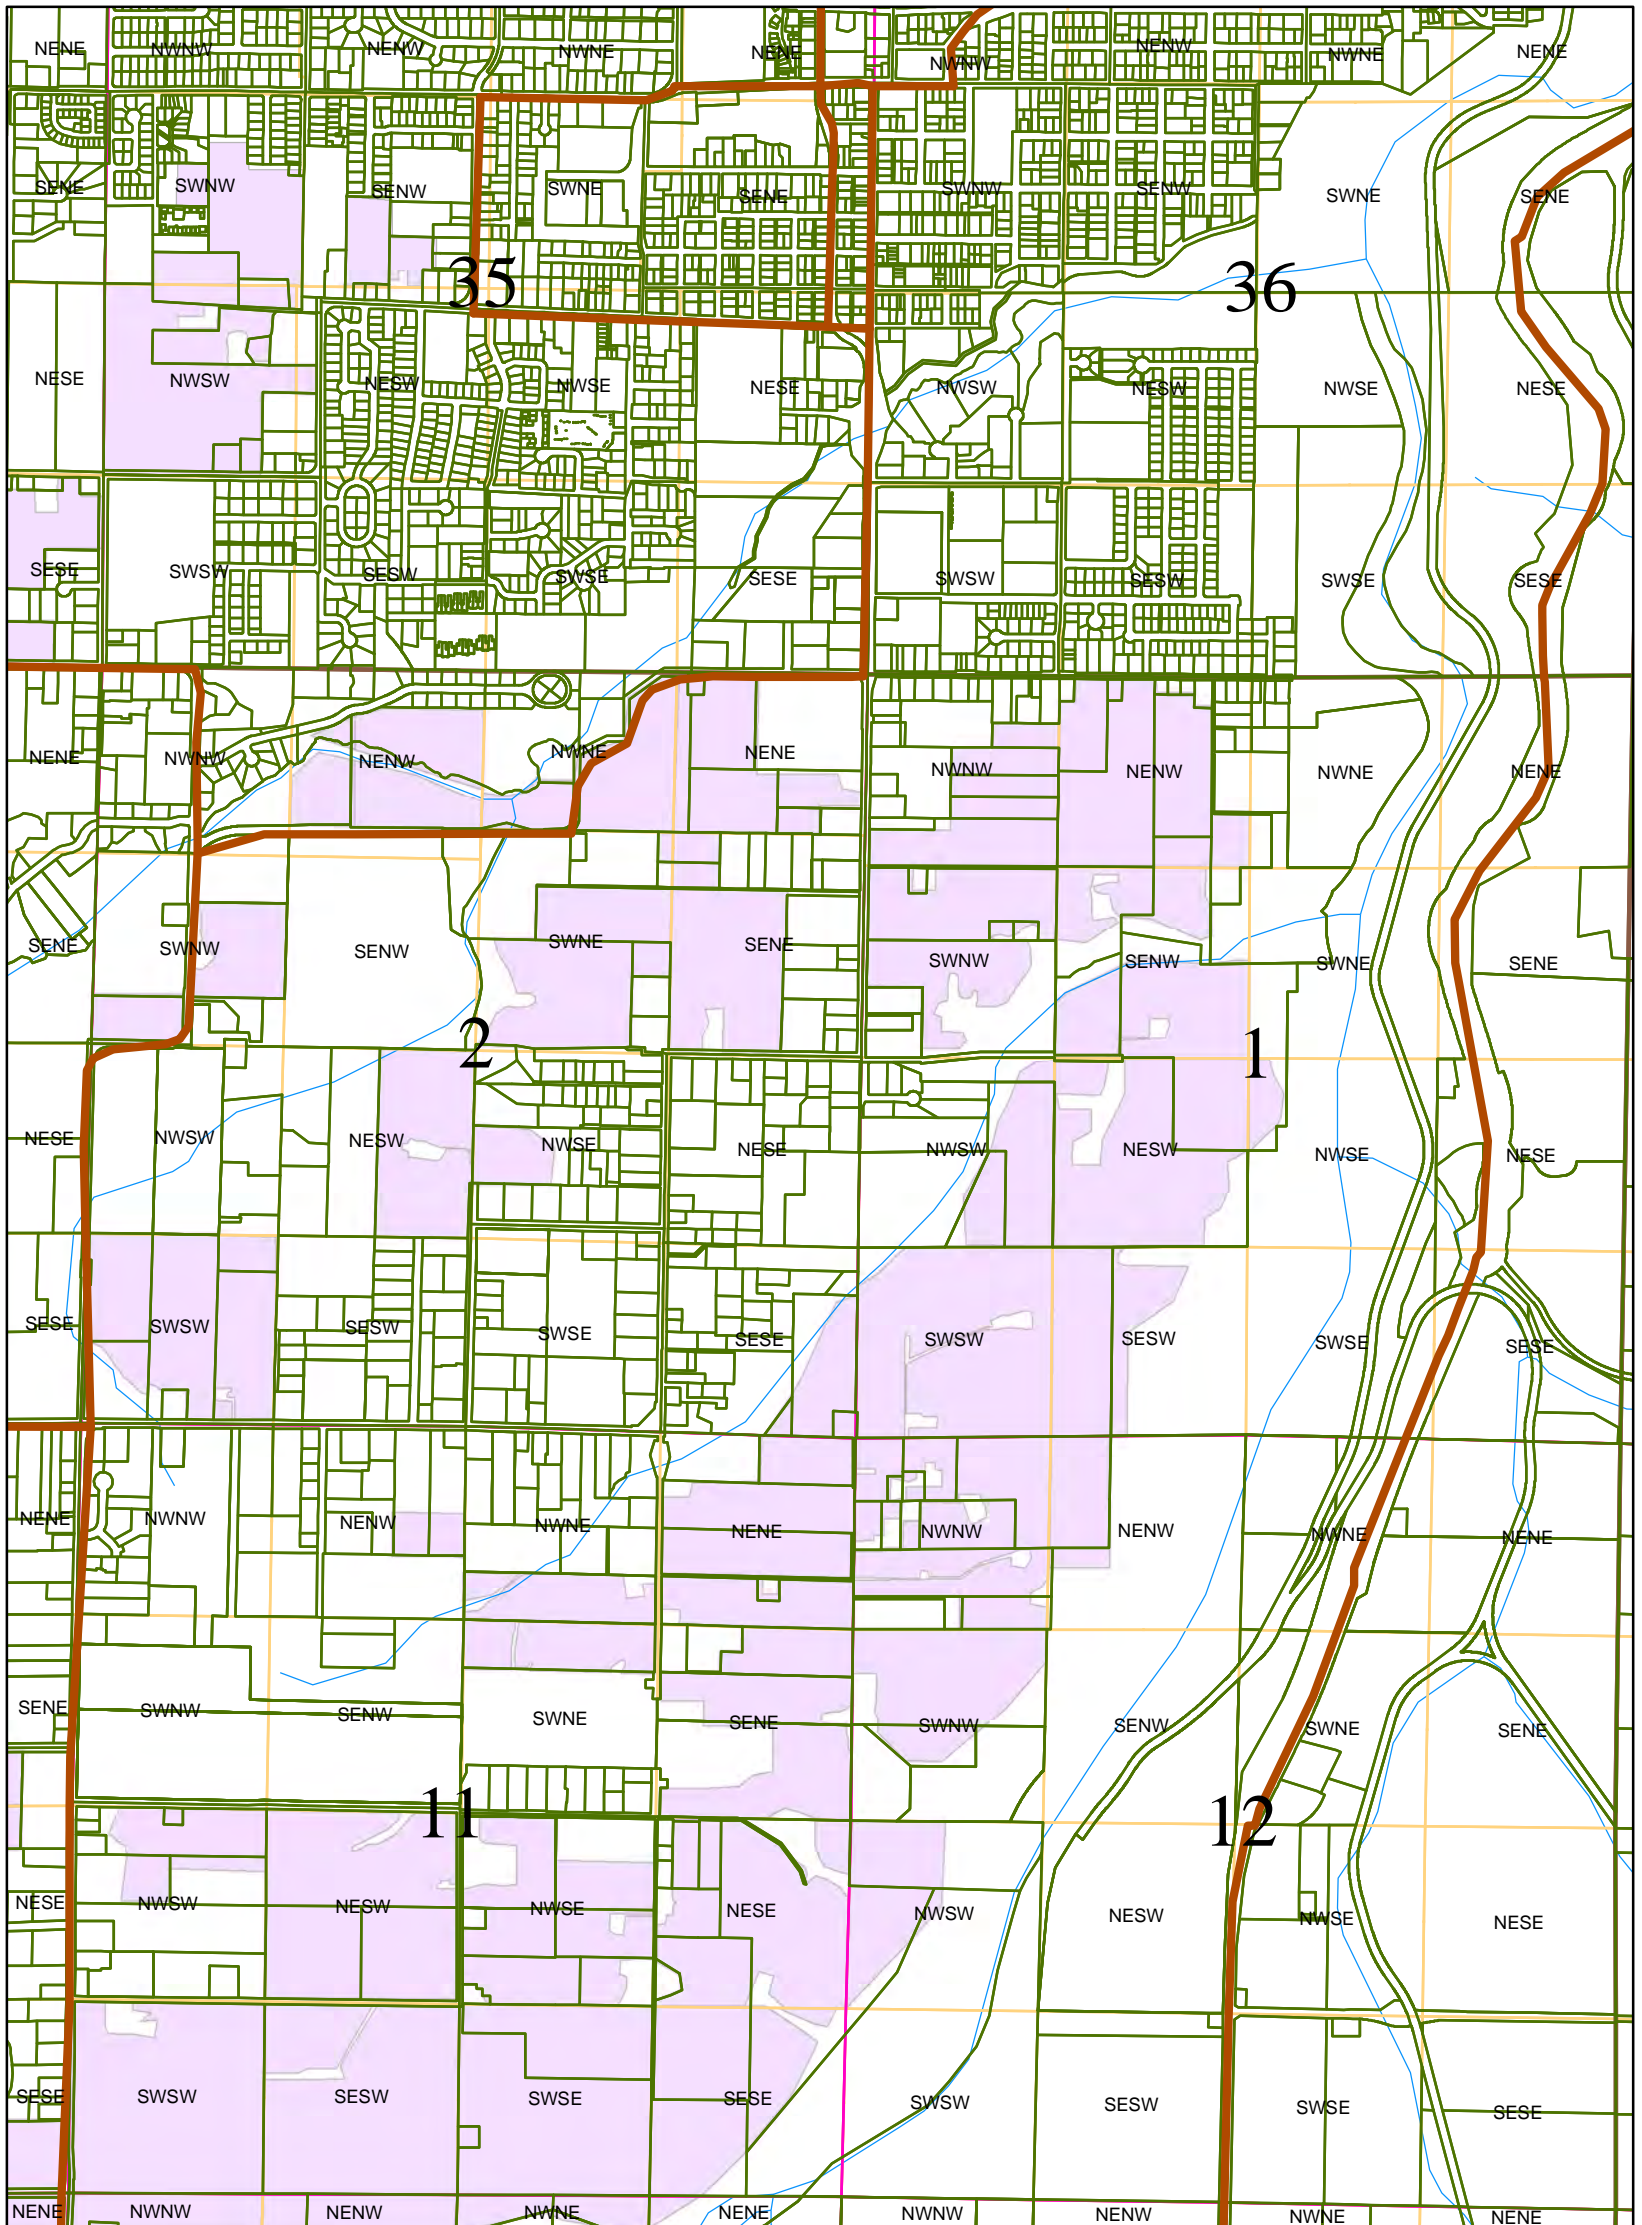

This map is not intended to provide legal dimensions or locations of property ownership lines

# Farmers Irrigation District Spray Use Permit 39822


Townships 2 and 3 North, Range 10 East, W.M.

**pous**  
**Permits**  
39822

## FINAL PROOF MAP



1 inch equals 1,320 feet

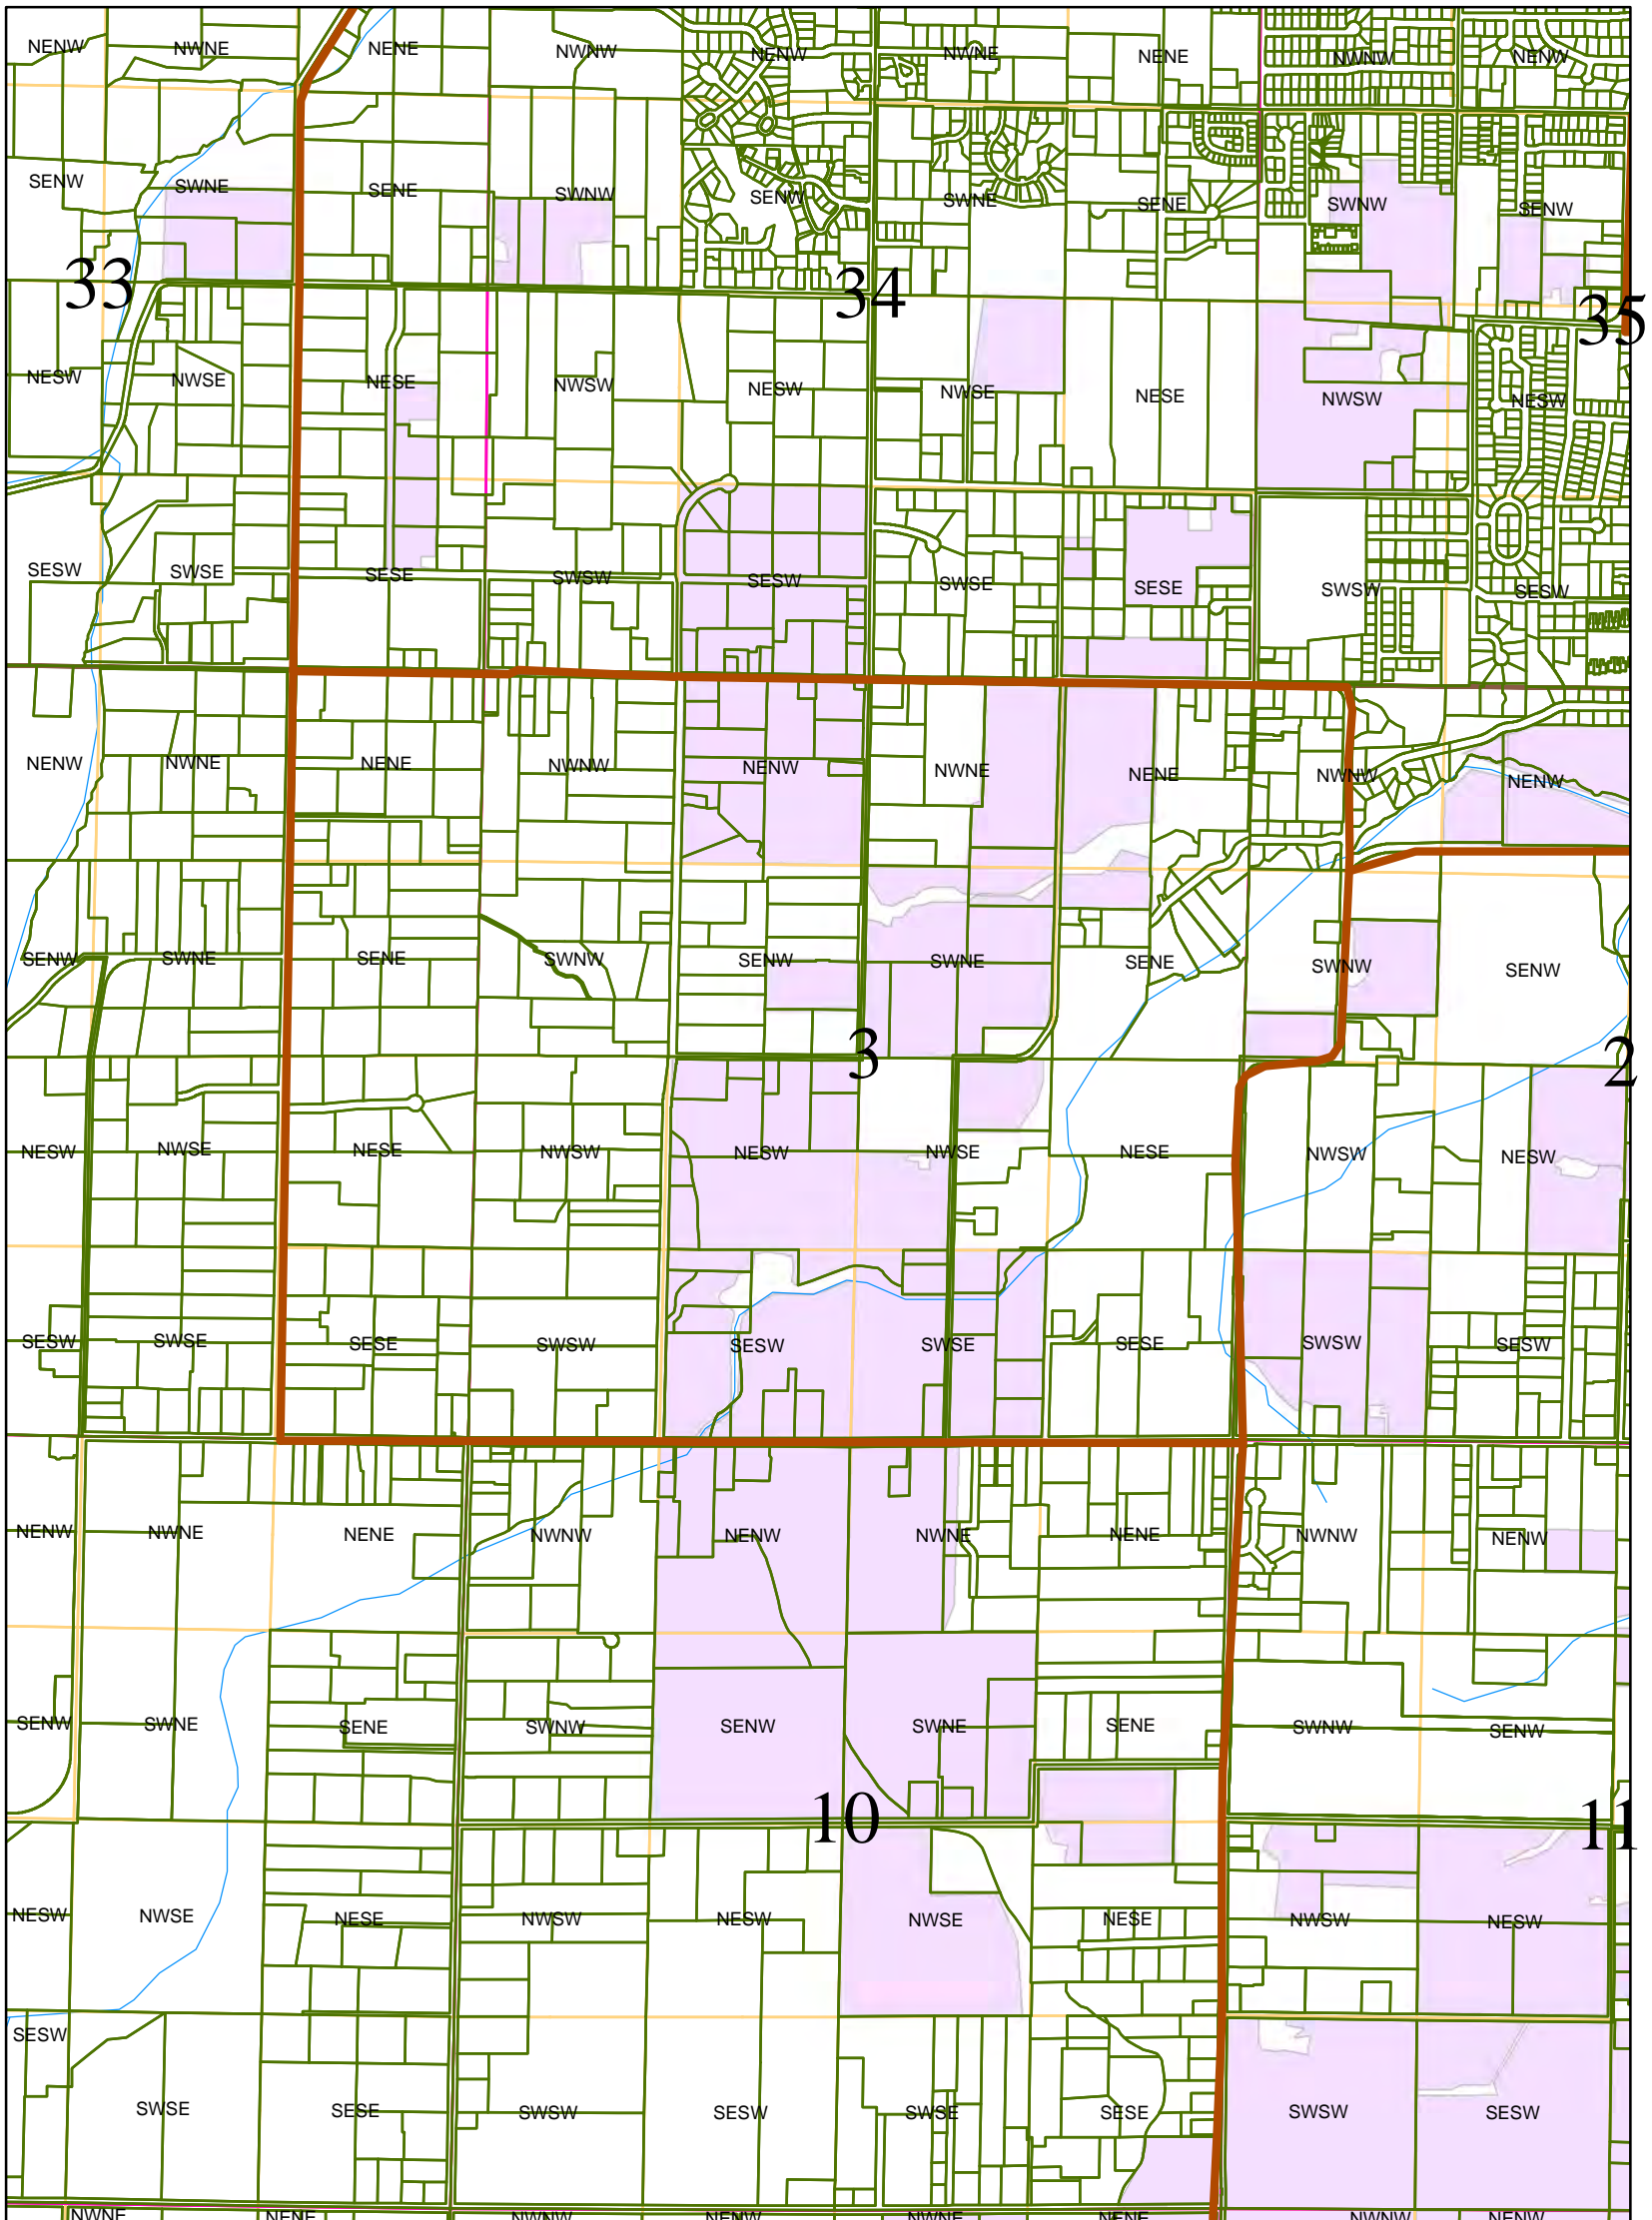

This map is not intended to provide legal dimensions or locations of property ownership lines



# Farmers Irrigation District Spray Use Permit 39822

Township 2 North, Range 10 East, W.M.

## FINAL PROOF MAP

**Permits**

39822



1 inch equals 1,320 feet

This map is not intended to provide legal dimensions or locations of property ownership lines

