

Farmers Irrigation District Spray Use Permit 41178

Townships 2 and 3 North, Range 10 East, W.M.


Permits

41178

FINAL PROOF MAP



1 inch equals 1,320 feet

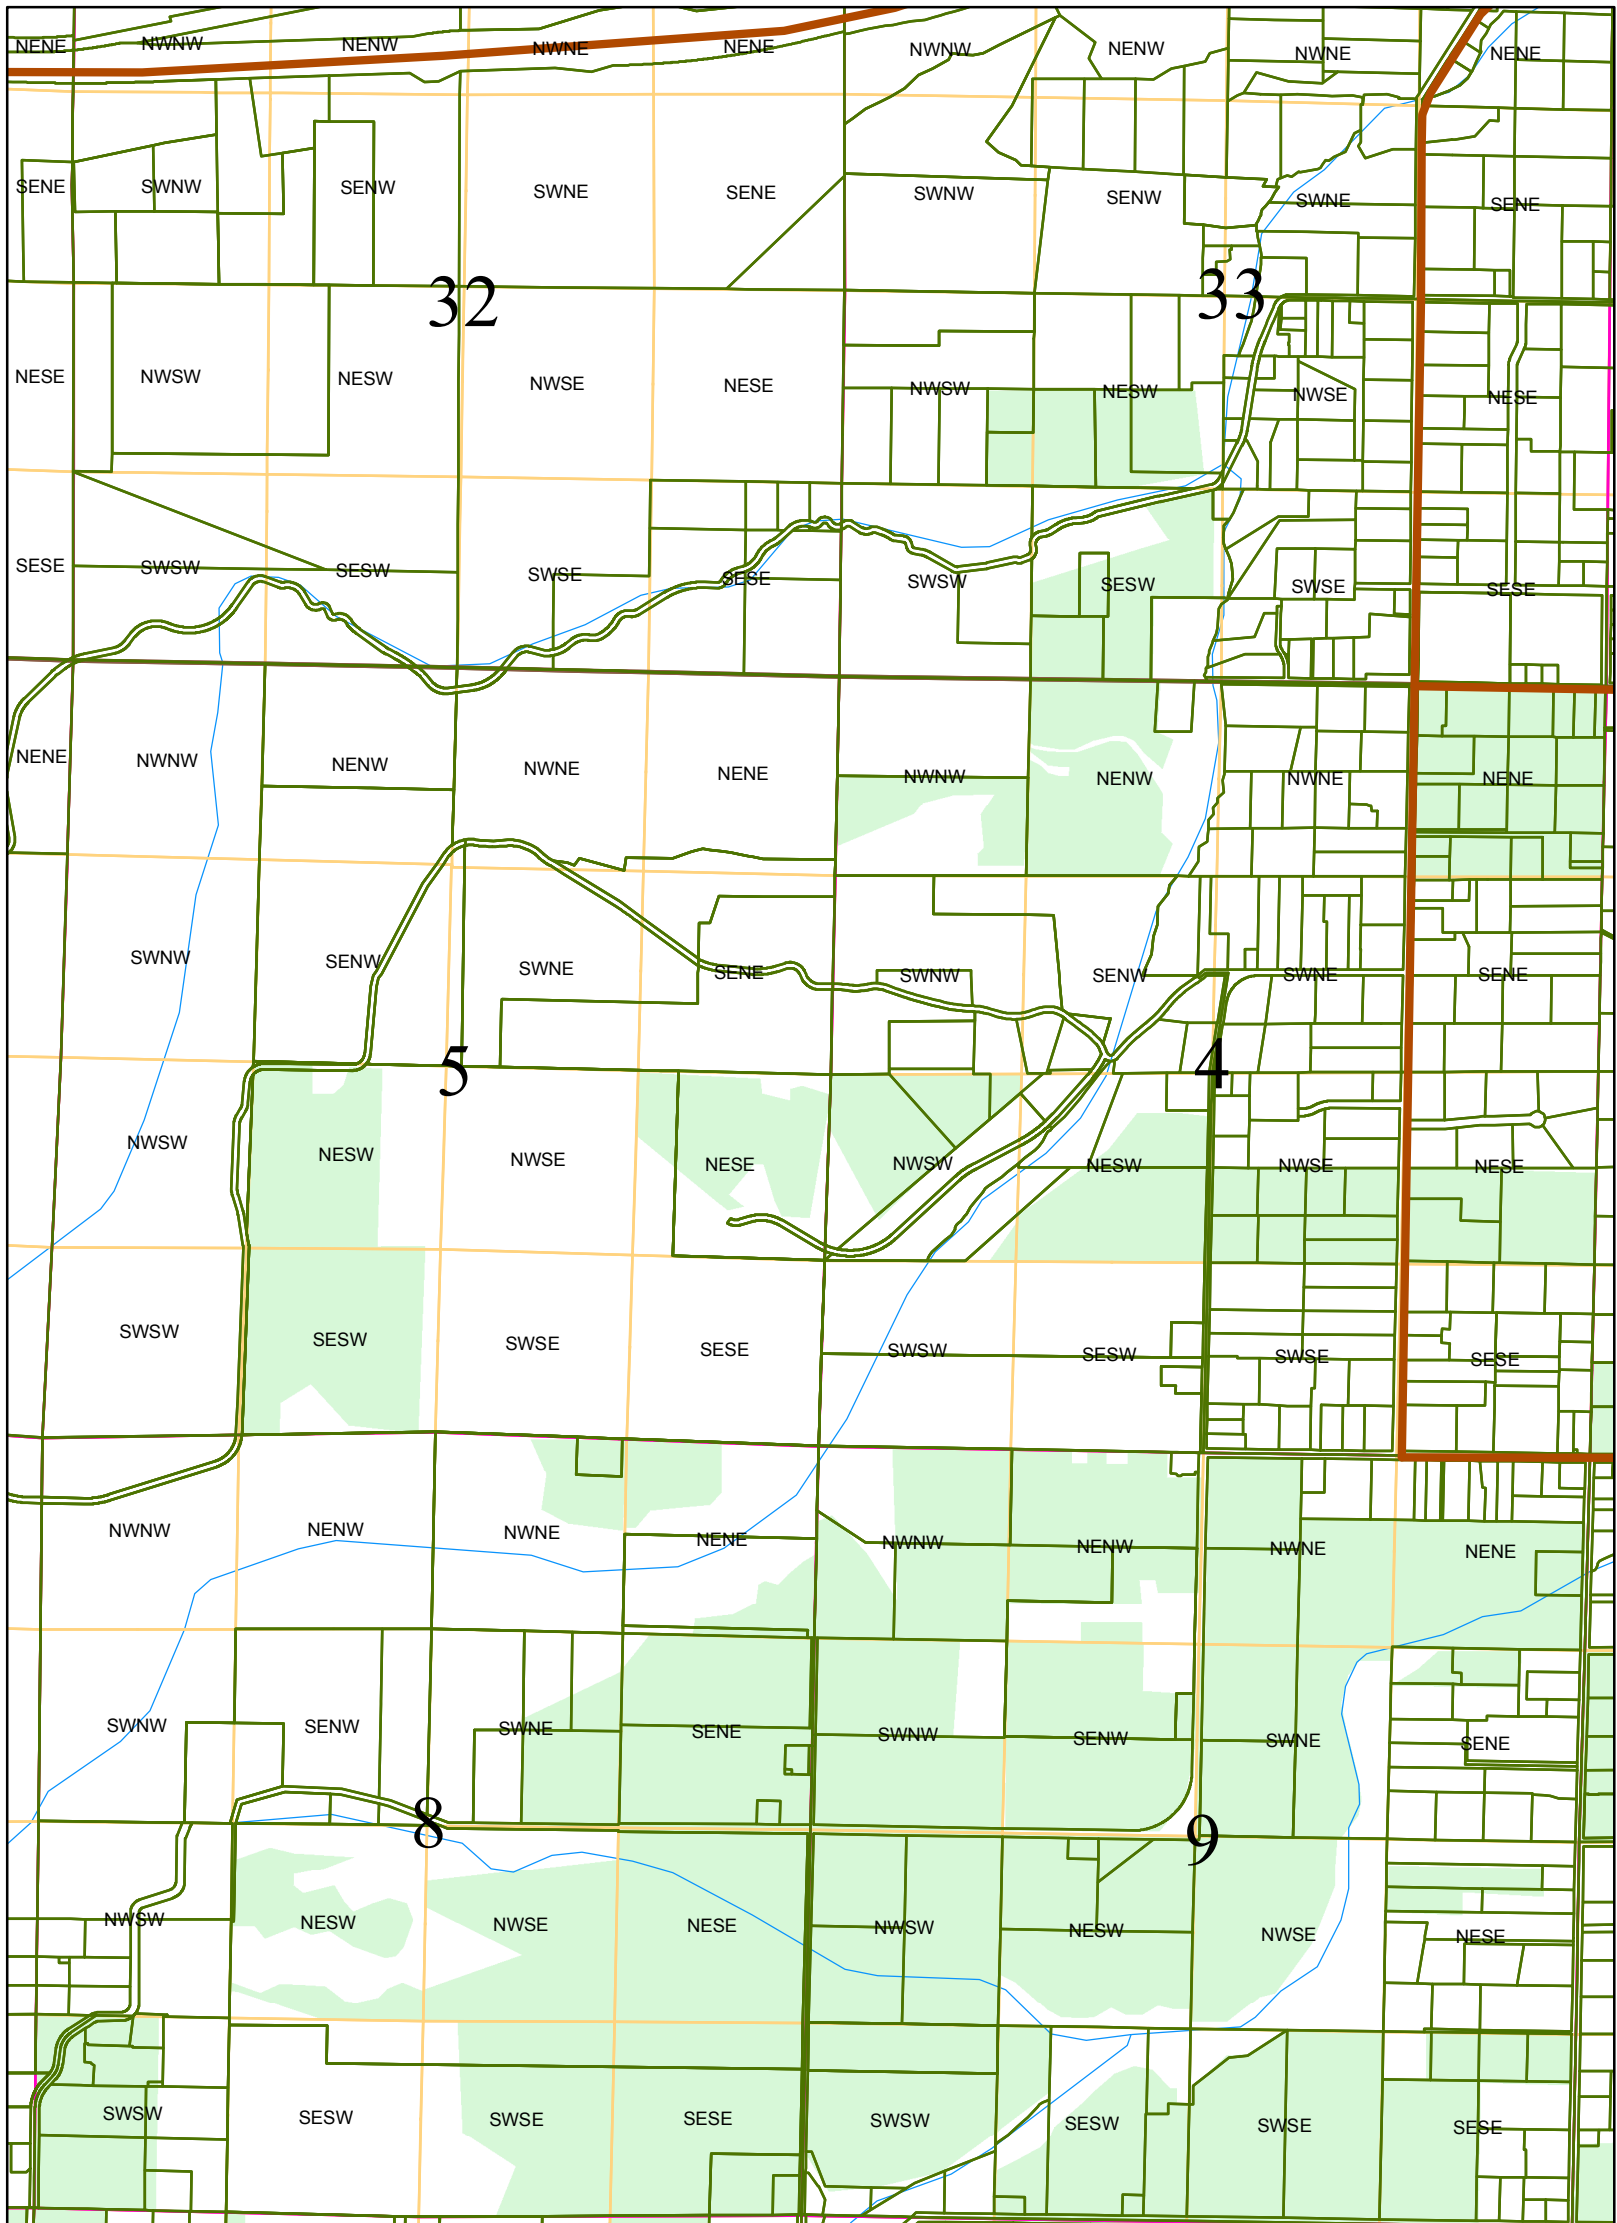

This map is not intended to provide legal dimensions or locations of property ownership lines

Farmers Irrigation District Spray Use Permit 41178

Township 2 North, Range 10 East, W.M.



This map is not intended to provide legal dimensions or locations of property ownership lines

1 inch equals 1,320 feet

FINAL PROOF MAP

