

CLAIM OF BENEFICIAL USE MAP FOR LONEROCK RANCH, INC. LOCATED IN SECTIONS 4 AND 5, T.06S., R.24E., W.M., GILLIAM COUNTY, OREGON W.O. 14-4533

PREPARED FOR


LONEROCK RANCH, INC.
26733 CAMPBELL LANE
CONDON, OR 97823

AGENTS

TIM CAMPBELL
(541) 384-3166
PAT CAMPBELL
(503) 784-0964


PREPARED BY

ARMSTRONG SURVEYING
& ENGINEERING, INC.
267 NE SECOND ST. STE. 100
PRINEVILLE, OR 97754
(541) 447-7791

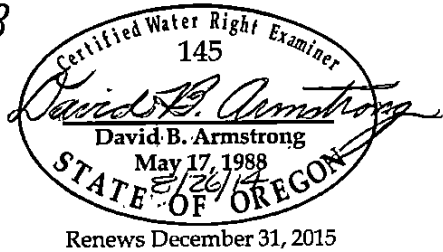

LEGEND

- TAX LOT 300 BOUNDARY
- ① WATER RIGHT - ACREAGE
- WATER OFF C.25357
- WATER ON C.25357
- WATER NO CHANGE C.25357
- RD. ROAD
- P MAINLINE PIPE-SIZE SHOWN
- POD POINT OF DIVERSION NO. 1

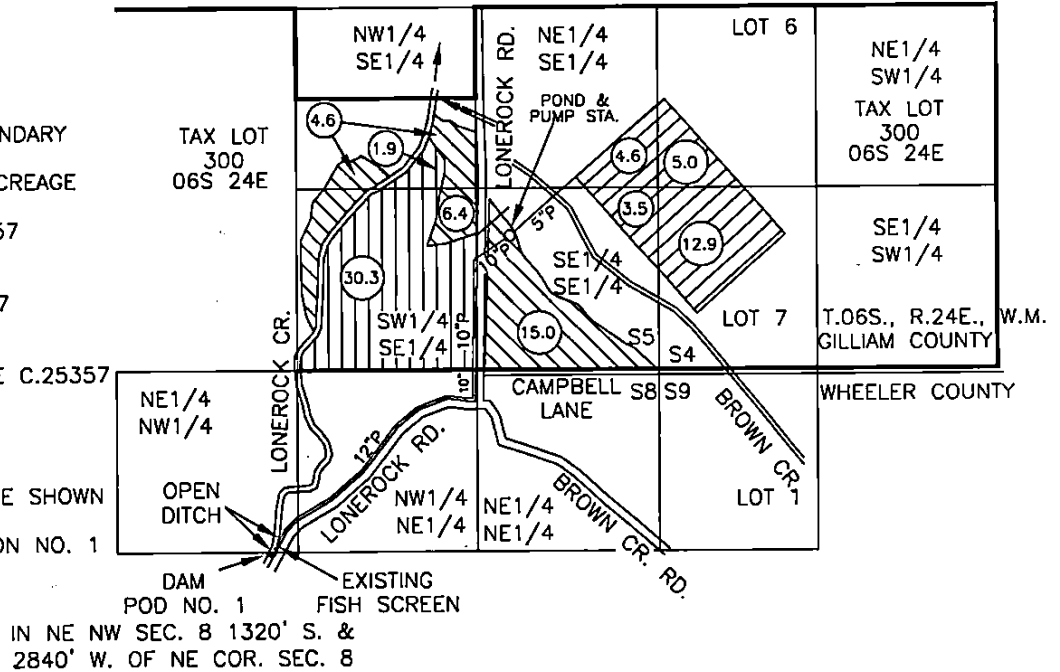


NOTE

THE PREPARATION OF THIS MAP
IS FOR THE PURPOSE OF
IDENTIFYING THE LOCATION OF
THE WATER RIGHT ONLY AND HAS
NO INTENT TO PROVIDE
DIMENSIONS OR LOCATIONS OF
PROPERTY OWNERSHIP LINES.

SCALE

1" = 1320'

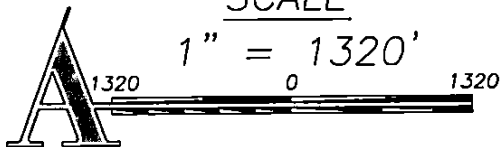

AUGUST 26, 2014

RECEIVED BY OWRD

SEP 25 2014

SALEM, OR



SHEET 1 OF 1
DRG. NO. 13-4361.DWG

W.O. 14-4533

T-11661