


T6S, R4W, WM

YAMHILL COUNTY

TAX LOT:
6 4 06 300

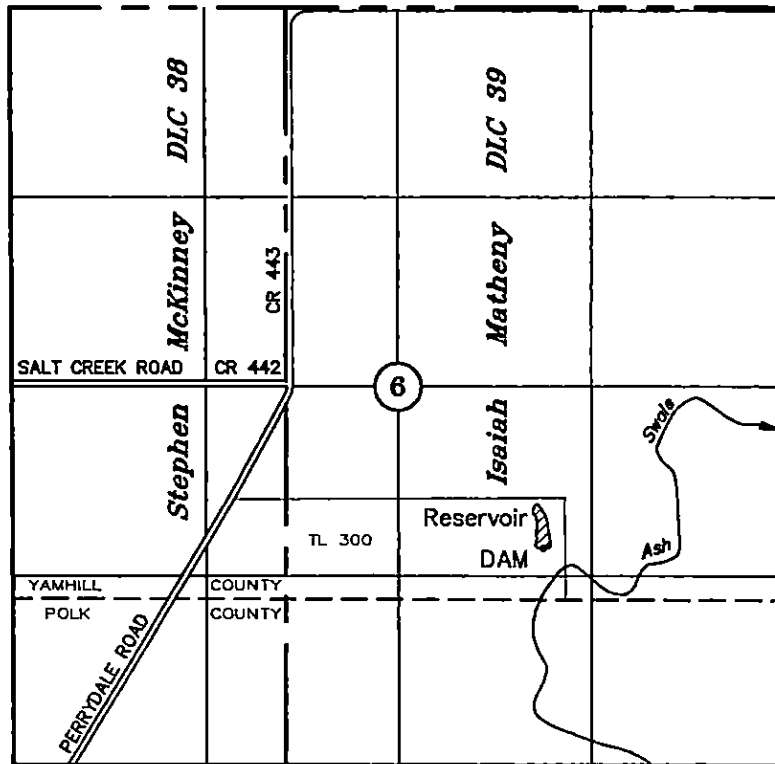

DAM: 3692' S AND 1778' E OF THE NW CORNER ISAIAH MATHENY DLC 39

CLAIM OF BENEFICIAL USE

UNDER

Application No. R-80384 Permit No. R-12390

IN THE NAME OF


Deolinda A. Coelho Revocable Living Trust

October 1, 2013

rev. November 28, 2017

SCALE: 1" = 1320'

NOV 29 2017

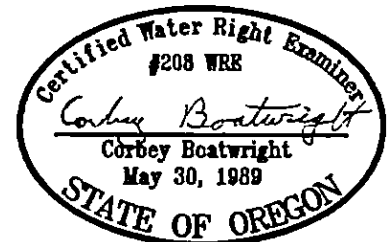

NOTE: This map is not intended to provide legal dimensions or locations of property ownership lines.

EXPIRES 12-31-17