


EXHIBIT B

T22S, R36E, W.M.
Harney County, Oregon

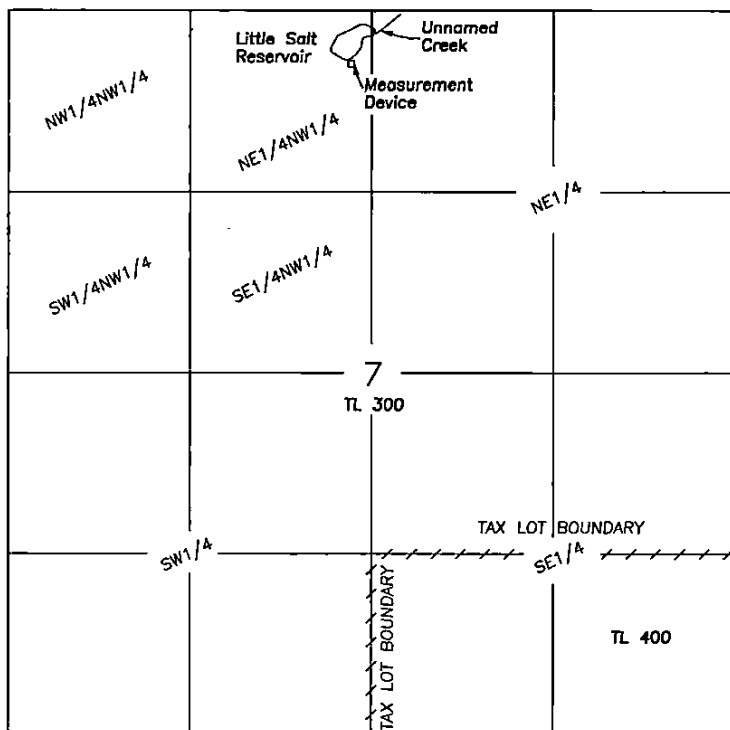

SCALE 1"=1320'

Outlet is located 330' South & 2760' West of the
NE corner of Section 7.
Measuring device is located 18' South of the outlet.

FINAL PROOF SURVEY
CLAIM OF BENEFICIAL USE
LITTLE SALT RESERVOIR

For

Bureau of Land Management

September 15, 2017

LEGEND

Application No. R-45427

Permit No. R-7889

Priority 9/25/1968

--- Tax Lot Boundary

A portion of Tax Lot
22-36 TL300

NOTE: Tax Lot 300 is owned by the BLM
and is more than 21,000 acres.
Therefore only a portion of the tax
lot boundary can be shown.

NOTE: The preparation of this map
was for the purpose of identifying
the location of the proposed water
right and has no intent to provide
dimensions or location of property
ownership lines.

Prepared by

Cornerstone Surveying, Inc

P.O. BOX 33

JOHN DAY, OR. 97845

(541)575-1813

cornerstonesurvey@centurytel.net

RECEIVED BY OWRD

NOV 03 2017

SALEM, OR

