
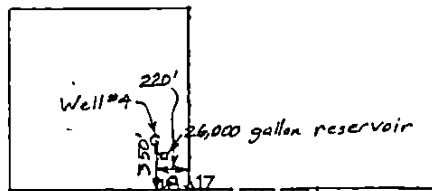


TOWNSHIP 16 SOUTH, RANGE 17 EAST, W.M.

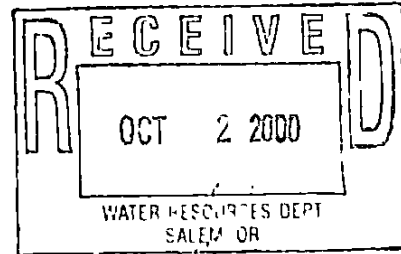


Claim of Beneficial Use Map
for


IDLEWAY IMPROVEMENT
DISTRICT

App G-11746
Per G-11507

Scale 1"=1320'

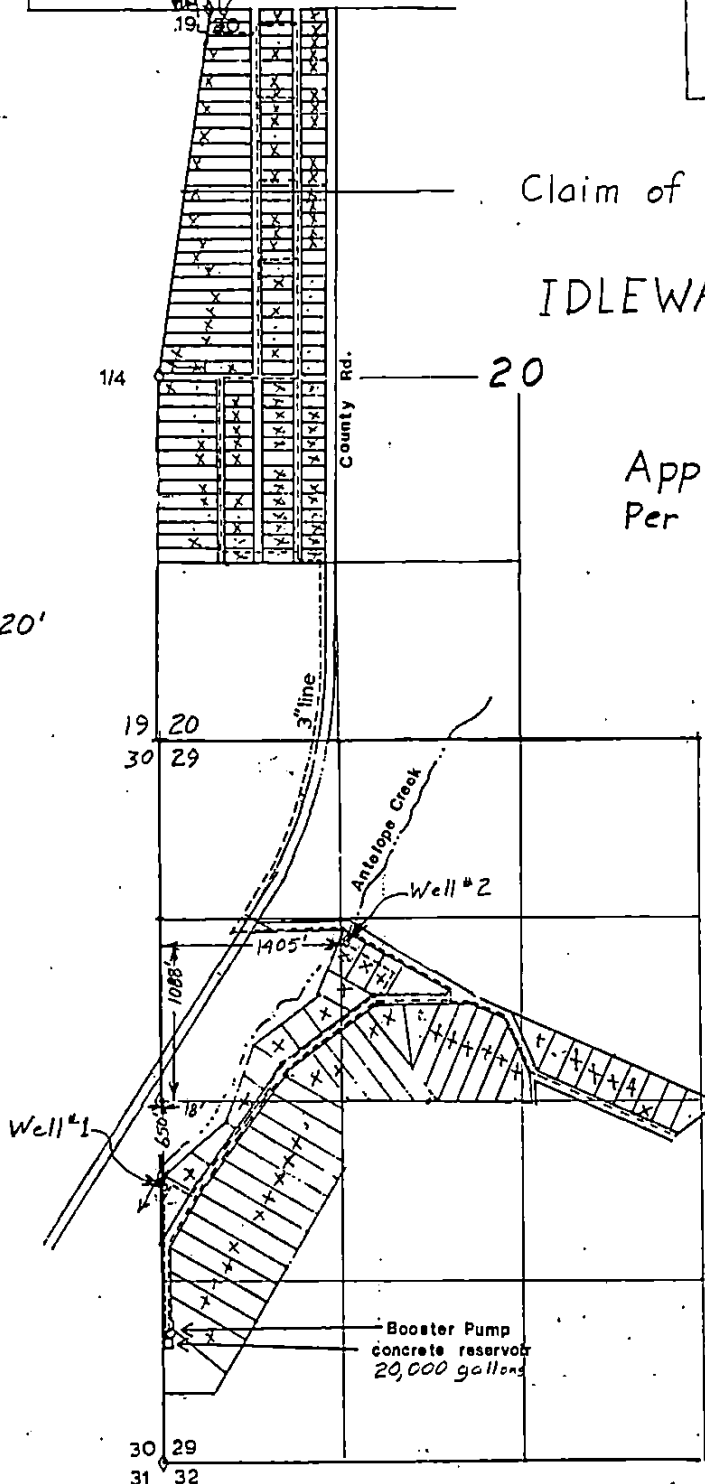

Surveyed Sep 21, 2000

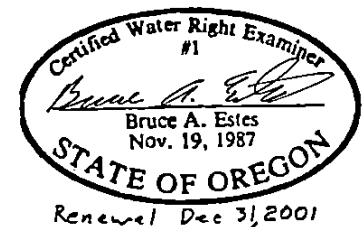

This map is for the purpose of
locating a water right only
and has no intent to provide
legal dimensions or the location
of property lines.

ESTES SURVEYS

PO Box 17519
Salem, OR 97305-7519
(503) 585-7593

60382 Arnold Rd
Bend, OR 97702
(541) 382-7391