


T. 41 S., R. 1 E., W. M.

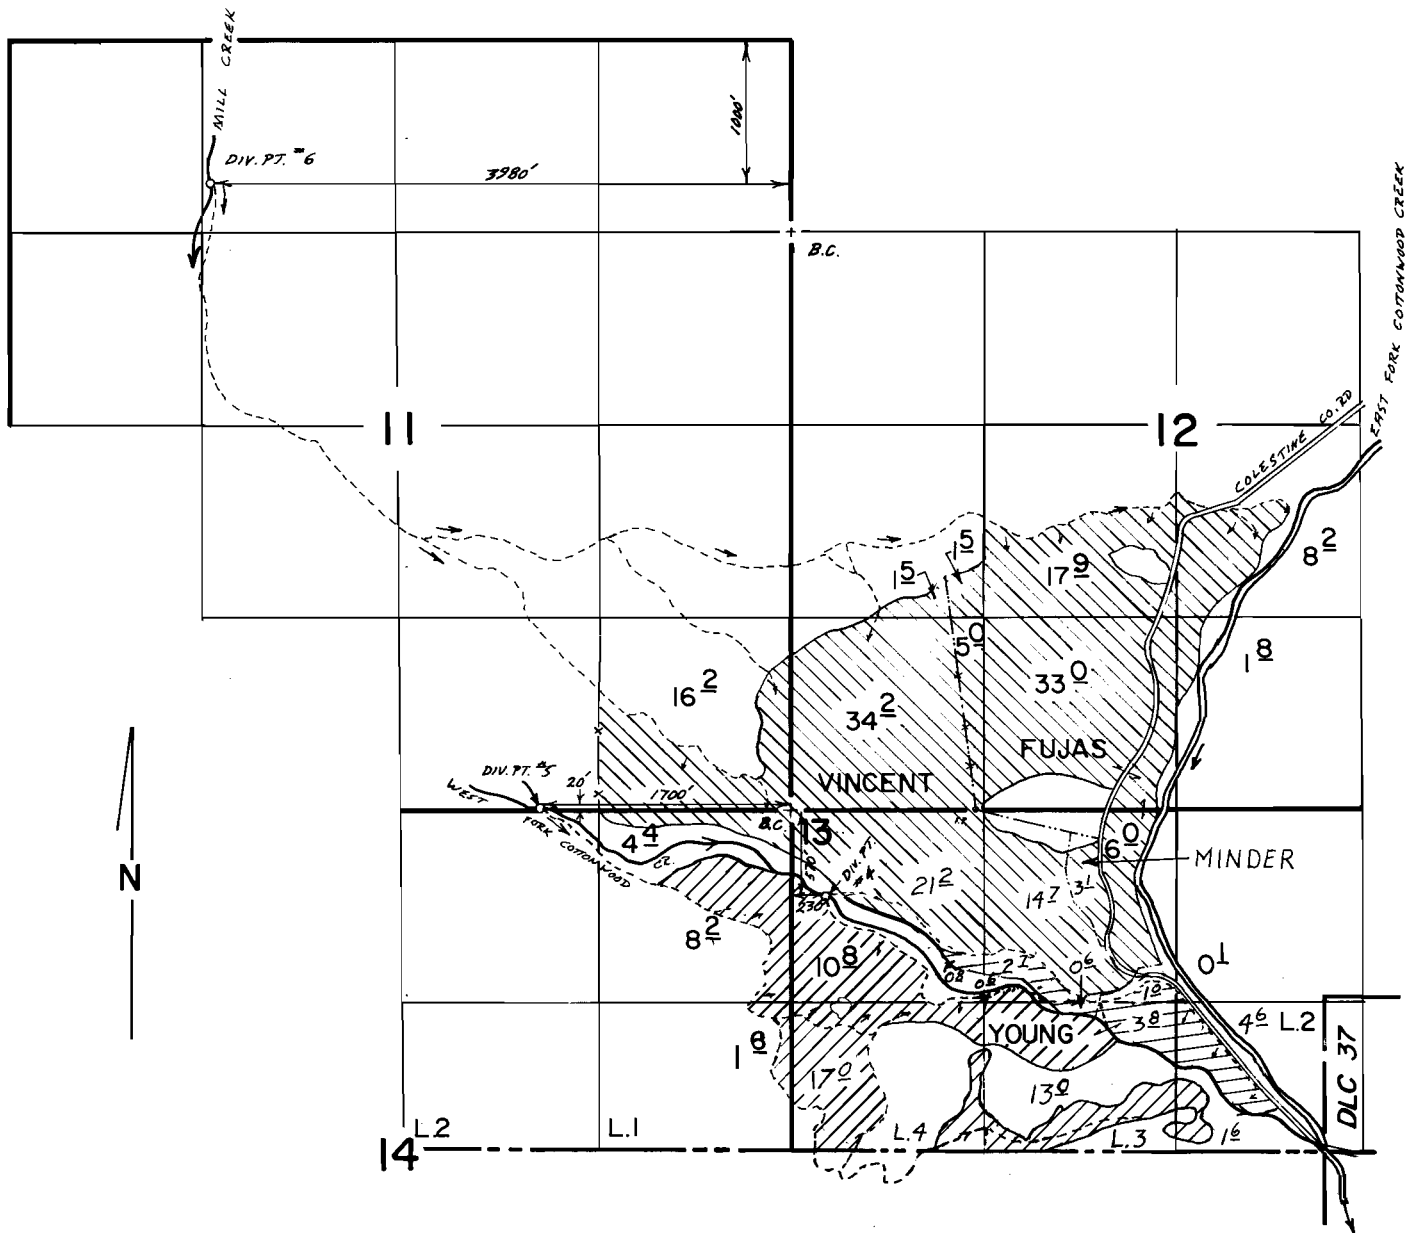

- DIV. PT. 4
 DIV. PT. 5
 DIV. PT. 6

Scale 1" = 1320'

FINAL PROOF SURVEY


UNDER

Application No. 58955. Permit No. 44755.....
IN NAME OF

MINDER, YOUNG, VINCENT, & FUJAS.....

Surveyed Sept. 12, 18, 1985, by B.S. JAMES.....

T.40S., R.2E., W.M.

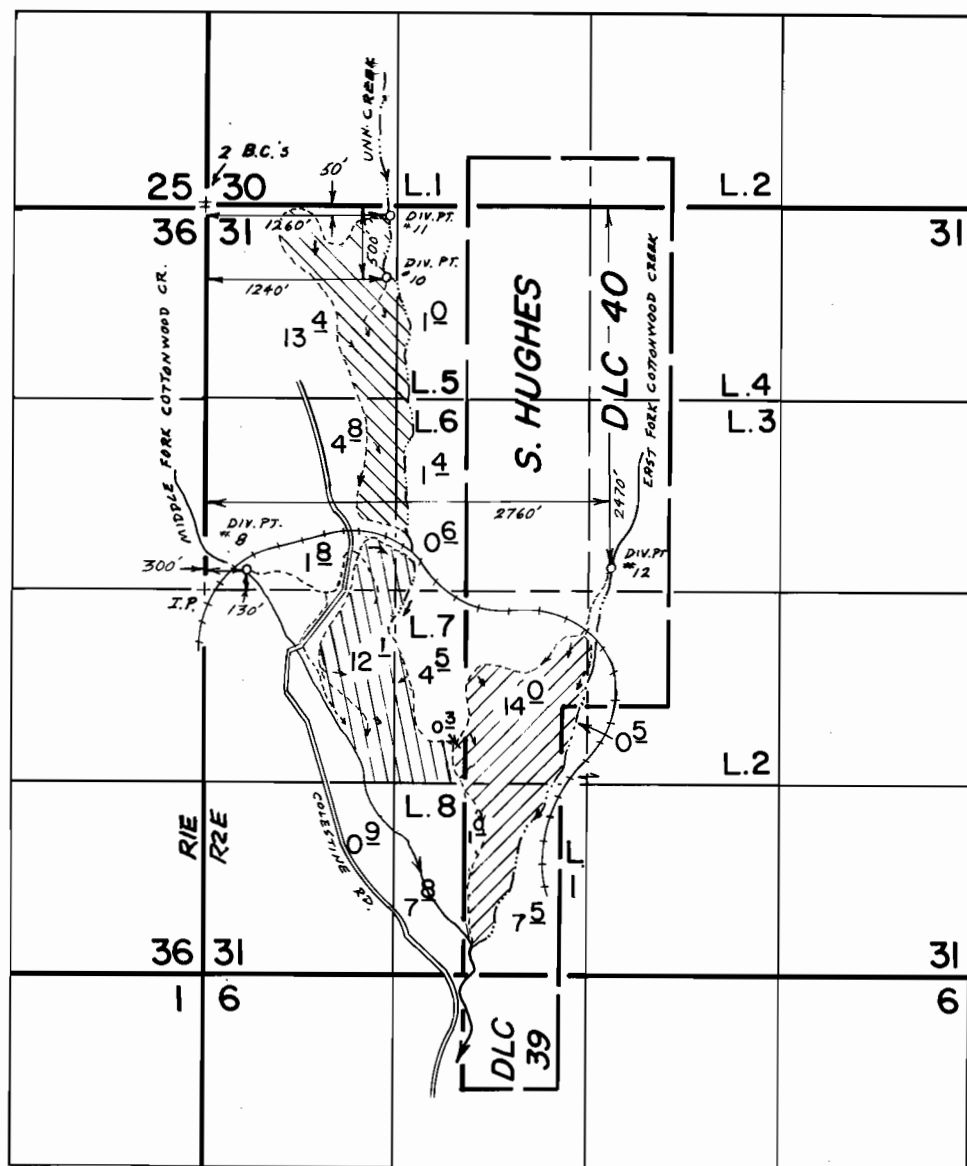

- DIV. PT. 8
 DIV. PTS. 10 & 11.
 DIV. PT. 12

Scale 1"=1320'

FINAL PROOF SURVEY

UNDER

Application No. 58955. Permit No. 44755....
IN NAME OF

.....L.B. PROPERTIES, & LARRY BARNES.....

Surveyed Sept. 12, 18, 19 85, by B.S. JAMES.....