


EXHIBIT B

T27S, R35E, W.M.
Harney County, Oregon

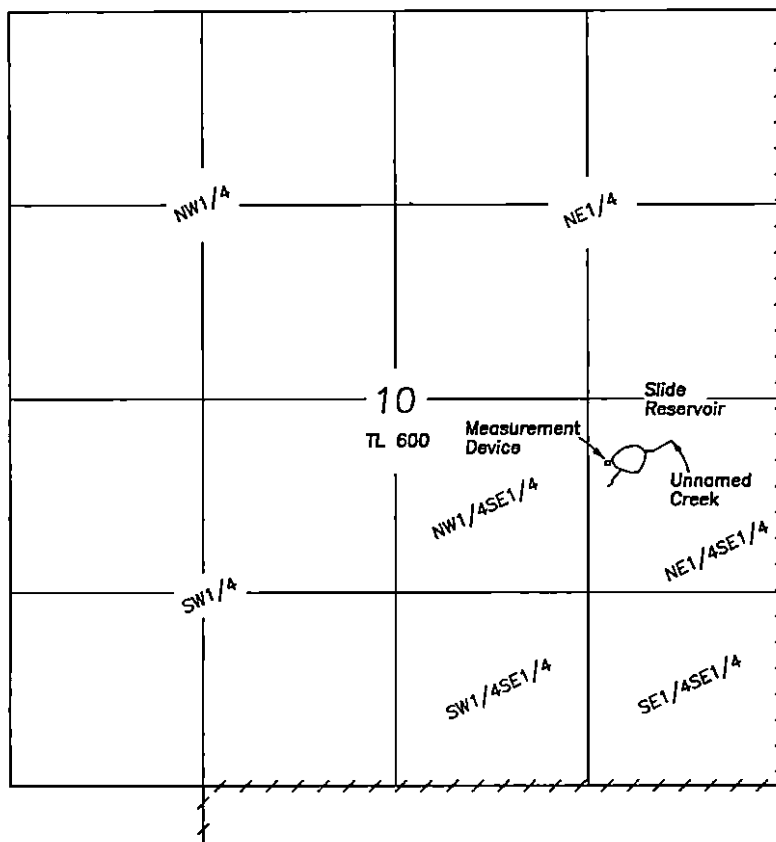

SCALE 1"=1320'

Outlet is located 2210' North & 1160' West of the
SE corner of Section 10.

Measuring device is located 7' South of the Outlet.

FINAL PROOF SURVEY
CLAIM OF BENEFICIAL USE
SLIDE RESERVOIR

For

Bureau of Land Management

September 25, 2017

LEGEND

Application No. R-66170

Permit No. R-11167

Priority 9/19/1983

----- Tax Lot Boundary

A portion of Tax Lot

27-35 TL600

NOTE: Tax Lot 600 is owned by the BLM
and is more that 3600 acres. A portion of
the boundary of tax lot 600 can be shown.

Prepared by

Cornerstone Surveying, Inc

P.O. BOX 33

JOHN DAY, OR. 97845

(541)575-1813

cornerstonesurvey@centurytel.net

NOTE: The preparation of this map
was for the purpose of identifying
the location of the proposed water
right and has no intent to provide
dimensions or location of property
ownership lines.

RECEIVED BY OWRD

NOV 03 2017

SALEM, OR

