


EXHIBIT B

T23S, R36E, W.M.
Harney County, Oregon

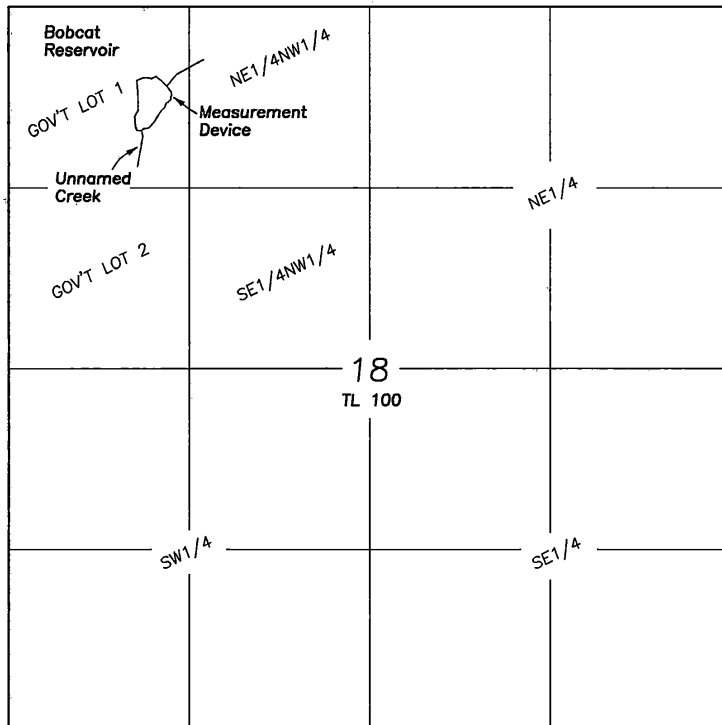

SCALE 1"=1320'

Outlet is located 660' South & 1190' East of the
NW corner of Section 18.

Measuring device is located 10' North of the outlet

FINAL PROOF SURVEY
CLAIM OF BENEFICIAL USE
BOBCAT RESERVOIR

For

Bureau of Land Management

September 15, 2017

LEGEND

Application No. R-47271

Permit No. R-7899

Priority 7/24/1970

A portion of Tax Lot
23-36 TL100

NOTE: Tax Lot 100 is owned by the BLM
and is more that 22,000 acres.
Therefore only a portion of the tax
lot boundary can be shown.

Prepared by
Cornerstone Surveying, Inc

P.O. BOX 33

JOHN DAY, OR. 97845

(541)575-1813

cornerstonesurvey@centurytel.net

RECEIVED BY OWRD

NOV 06 2017

SALEM, OR

NOTE: The preparation of this map
was for the purpose of identifying
the location of the proposed water
right and has no intent to provide
dimensions or location of property
ownership lines.

