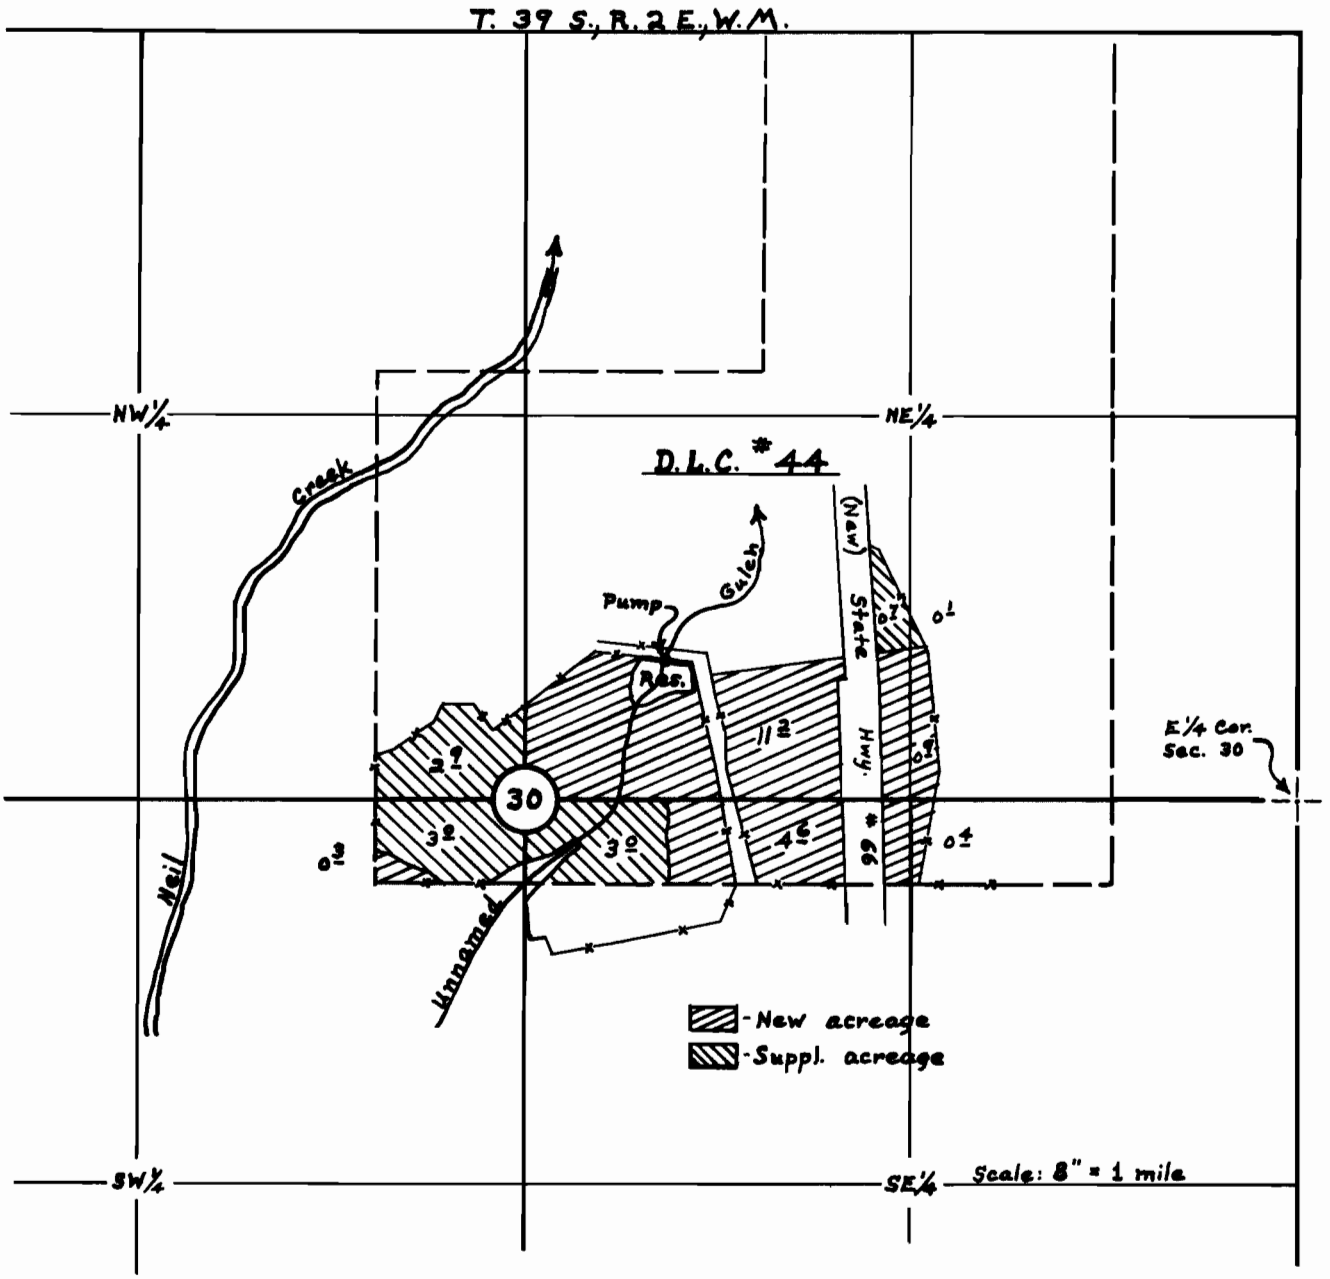

FINAL PROOF SURVEY

UNDER

Application No. R-30595 30596 Permit No. R-1842 24093

IN NAME OF

K.W. Corp., M.D.

Surveyed Dec. 7 1960, by D.C. Hendrix