

T. 17 S.,
R. 19 E., W.M.



Scale 1" = 1320'
(4" = 1 mile)

Surveyed July 14, 2016

- ⊗ 32[±] acres
- C-87791 45[±] acres
- C-87793 49[±] acres


Claim of Beneficial Use
for
Shotgun Ranch, LLC

App G-17814
Per G-17307

RECEIVED BY QWRD

NOV 14 2016

SALEM, OR

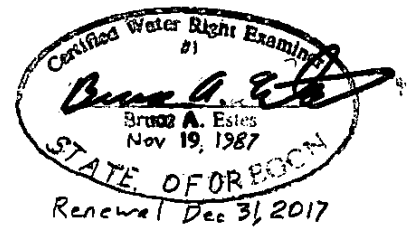

This map is for the purpose of locating a water right only and has no intent to provide larger dimensions or the location of property lines.

ESTES SURVEYS, LLC
 PO Box 17519 60382 Arnold Rd
 Salem, OR 97305-7519 Bend, OR 97702
 (503) 585-7500 (541) 382-7391