

CLAIM OF BENEFICIAL USE MAP

LOCATED IN THE NORTHWEST 1/4 OF SECTION 10,
TOWNSHIP 33 SOUTH, RANGE 15 WEST, W.M., CURRY COUNTY, OREGON
APPLICATION S-81461, PERMIT S-53165



SCALE
1" = 200 FT.


SURVEY METHOD:

THE POINT OF DIVERSION WAS TIED BY TOTAL STATION TRAVERSE TO THE MONUMENTS SHOWN PER CURRY COUNTY PARTITION PLAT 1991-46. THE POSITION OF THE CENTER 1/4 CORNER OF SECTION 10 WAS CALCULATED BASED ON DIMENSIONS SHOWN PER SAID PARTITION.

RECEIVED BY OWRD

OCT 27 2017

SALEM, OR

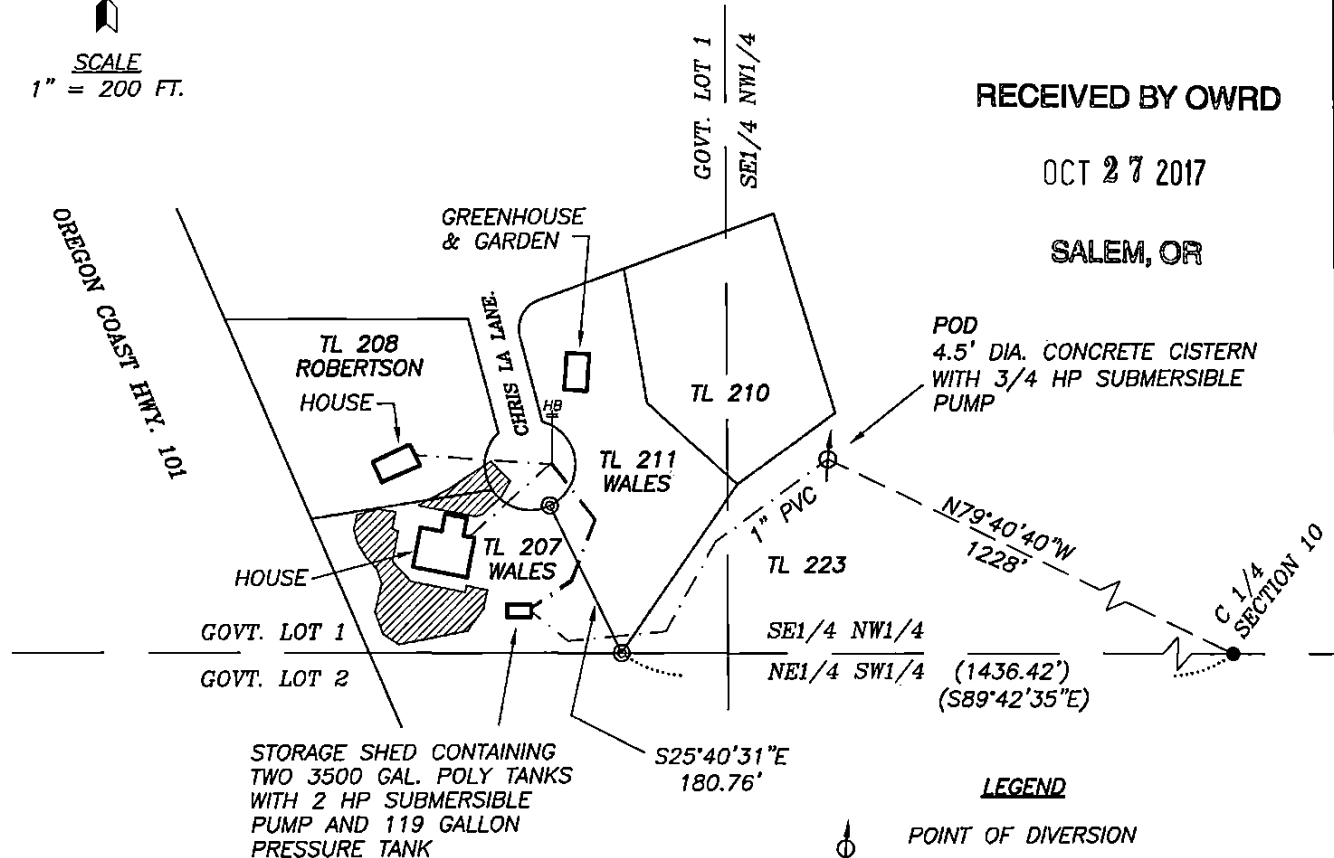

LEGEND

- POINT OF DIVERSION
- 1" PVC PIPE
- FOUND MONUMENT PER PARTITION PLAT 1991-46
- CALCULATED POSITION
- HOSE BIB
- IRRIGATED AREA = 0.3 ACRES
- () RECORD DIMENSION PER PARTITION PLAT 1991-46

NOTE:

THE POINT OF DIVERSION BEARS NORTH 79°40'40" WEST 1228 FEET FROM THE CENTER 1/4 CORNER OF SECTION 10.

EXAMINER'S DISCLAIMER STATEMENT

THE PREPARATION OF THIS MAP WAS FOR THE PURPOSE OF IDENTIFYING THE LOCATION OF THE WATER RIGHT ONLY AND HAS NO INTENT TO PROVIDE DIMENSIONS OR LOCATION OF PROPERTY OWNERSHIP LINES.



Stuntzner

Engineering
& Forestry, LLC

705 S. 4TH ST.
P.O. BOX 118
COOS BAY, OREGON 97420

PHONE: (541) 267-2872
FAX: (541) 267-0588
www.stuntzner.com

Engineering - Land Surveying - Forestry - Land Planning - Water Rights

JOB #: 114-012
DATE: rev. 10-18-17
DRAWN BY: CMW
CHECKED BY: CMW

PREPARED
FOR:

Mike Wales
Port Orford, Oregon

FILE NAME: 114-012 Wales COBU_2017.dwg

SHEET 1 OF 1