
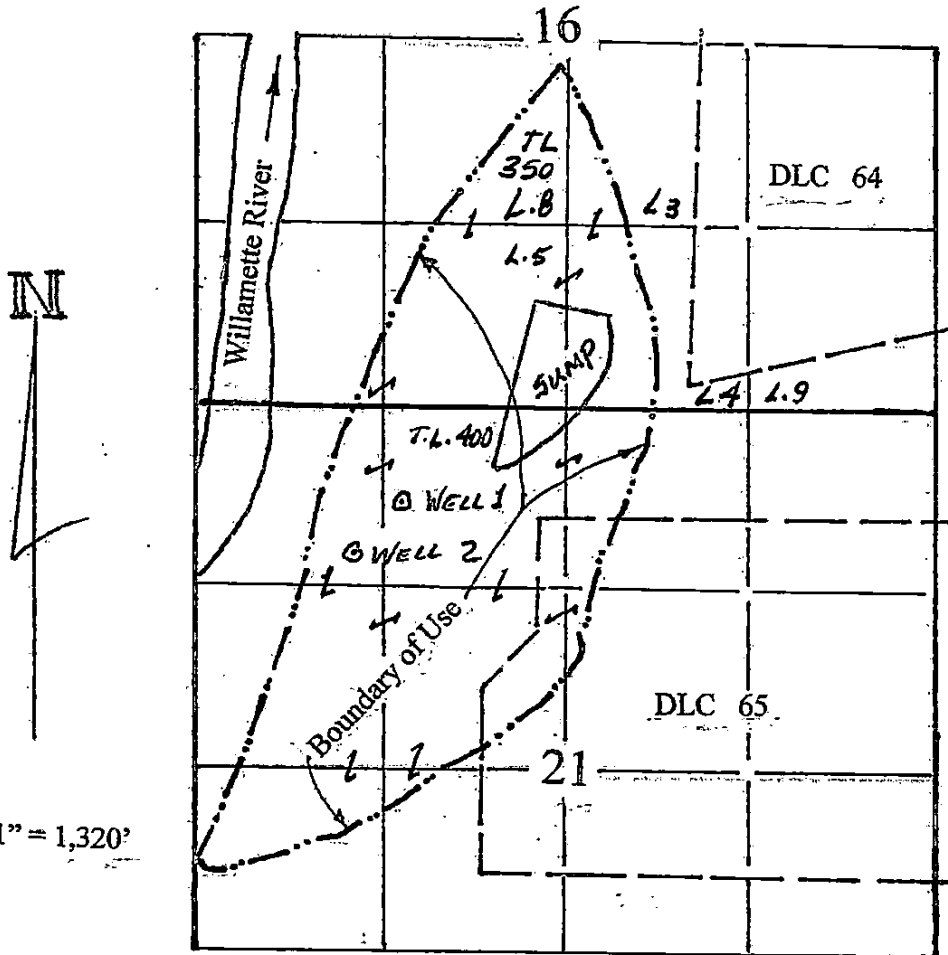


Map to Accompany Claim of Beneficial Use
 For Application G-16170, Permit G-15957,
 In the Name of
 Oregon Division of State Lands

T. 6'S., R. 3 W., WM
 Sections 16 & 21

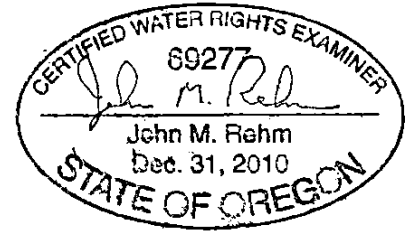

Scale; 1" = 1,320'

RECEIVED
 APR 06 2017
 OWRD

Note: All meters installed on main lines within 20' of pumps.

POD's Located: Well 1- 700' S. & 3870' W.;
 Well 2 - 1080' S. & 4230' W.;
 Sump - 360' N. & 2750' W.;
 All from the NE Cor. Section 21

This map is for the purpose of identifying the location of water rights only, and is not
 Intended to provide legal dimensions or locations of property lines.

Handwritten signature or initials.