


CLAIM OF BENEFICIAL USE MAP FOR T-10793  
T38S, R8W, WM, Parts of Sections 9 and 10, Josephine County

October 20, 2014

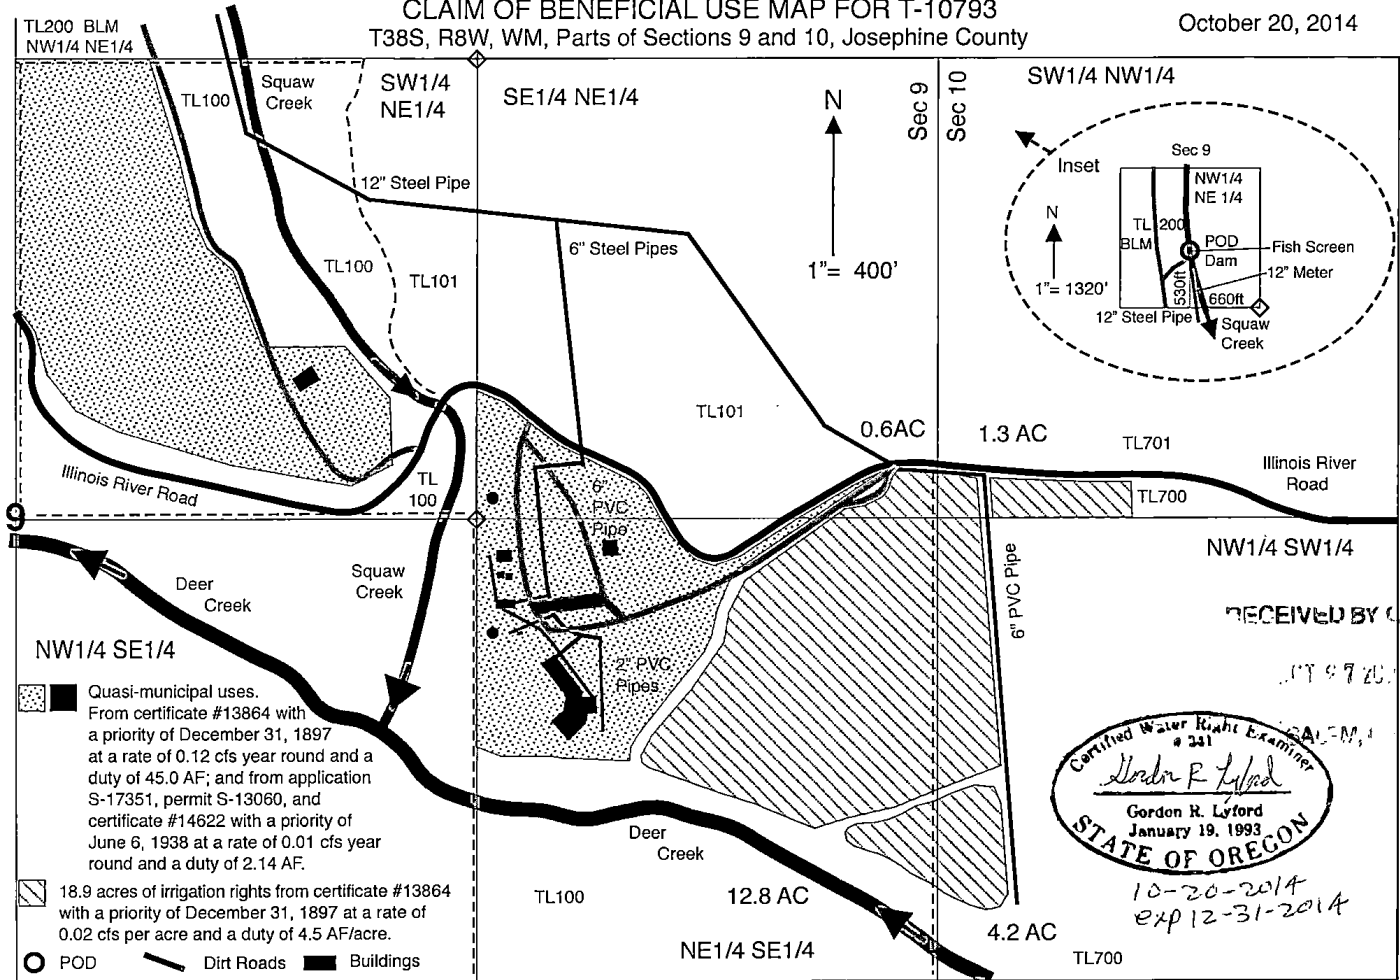

This map was drawn by Gordon R. Lyford for the Siskiyou Field Institute to support their Claim of Beneficial Use under T-10793. The SFI owns tax lots 100 and 700.

This map was prepared for the purpose of identifying the location of water rights only and is not intended to provide legal dimensions or the location of property ownership lines.