


T23S, R32½E

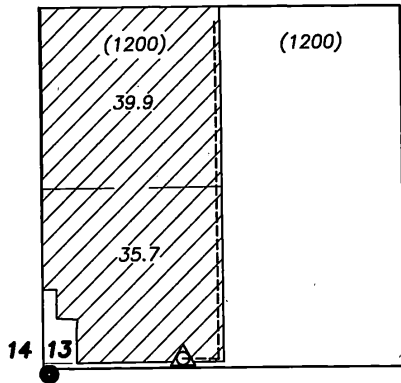

SCALE: 1" = 1320'

POA IS 60 FT. NORTH AND 1020 FT. EAST FROM THE TRUE SW COR. SEC. 13, T.23S., R.32½E.

FINAL PROOF SURVEY
APPLICATION NO. G-16961
PERMIT NO. G-16434

IN NAME OF
FRED TEUTSCH

BY

ROBERT D. BAGETT
217 N. CANYON BLVD.
JOHN DAY, OREGON
(541) 575-1251

DATE SURVEYED: NOV. 22, 2013


△ POA - WELL AND INLINE FLOW METER

----- EXISTING MAINLINE

● FOUND RECORD SURVEY MONUMENT WHICH IS 40 FT. SOUTH AND 40 EAST OF THE SW COR. SEC. 13

▨ CURRENT PLACE OF USE

() TAX LOT

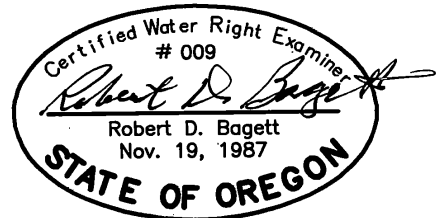

RECEIVED BY OWRD

FEB 28 2014

SALEM, OR

NOTE: THE PREPARATION OF THIS MAP WAS FOR THE PURPOSE OF IDENTIFYING THE LOCATION OF THE PROPOSED WATER RIGHT AND HAS NO INTENT TO PROVIDE DIMENSIONS OR LOCATION OF PROPERTY OWNERSHIP LINES.