
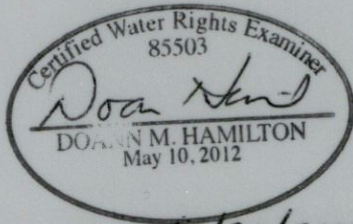


T.15S. R.12E. Sec. 10 & 11, W.M.

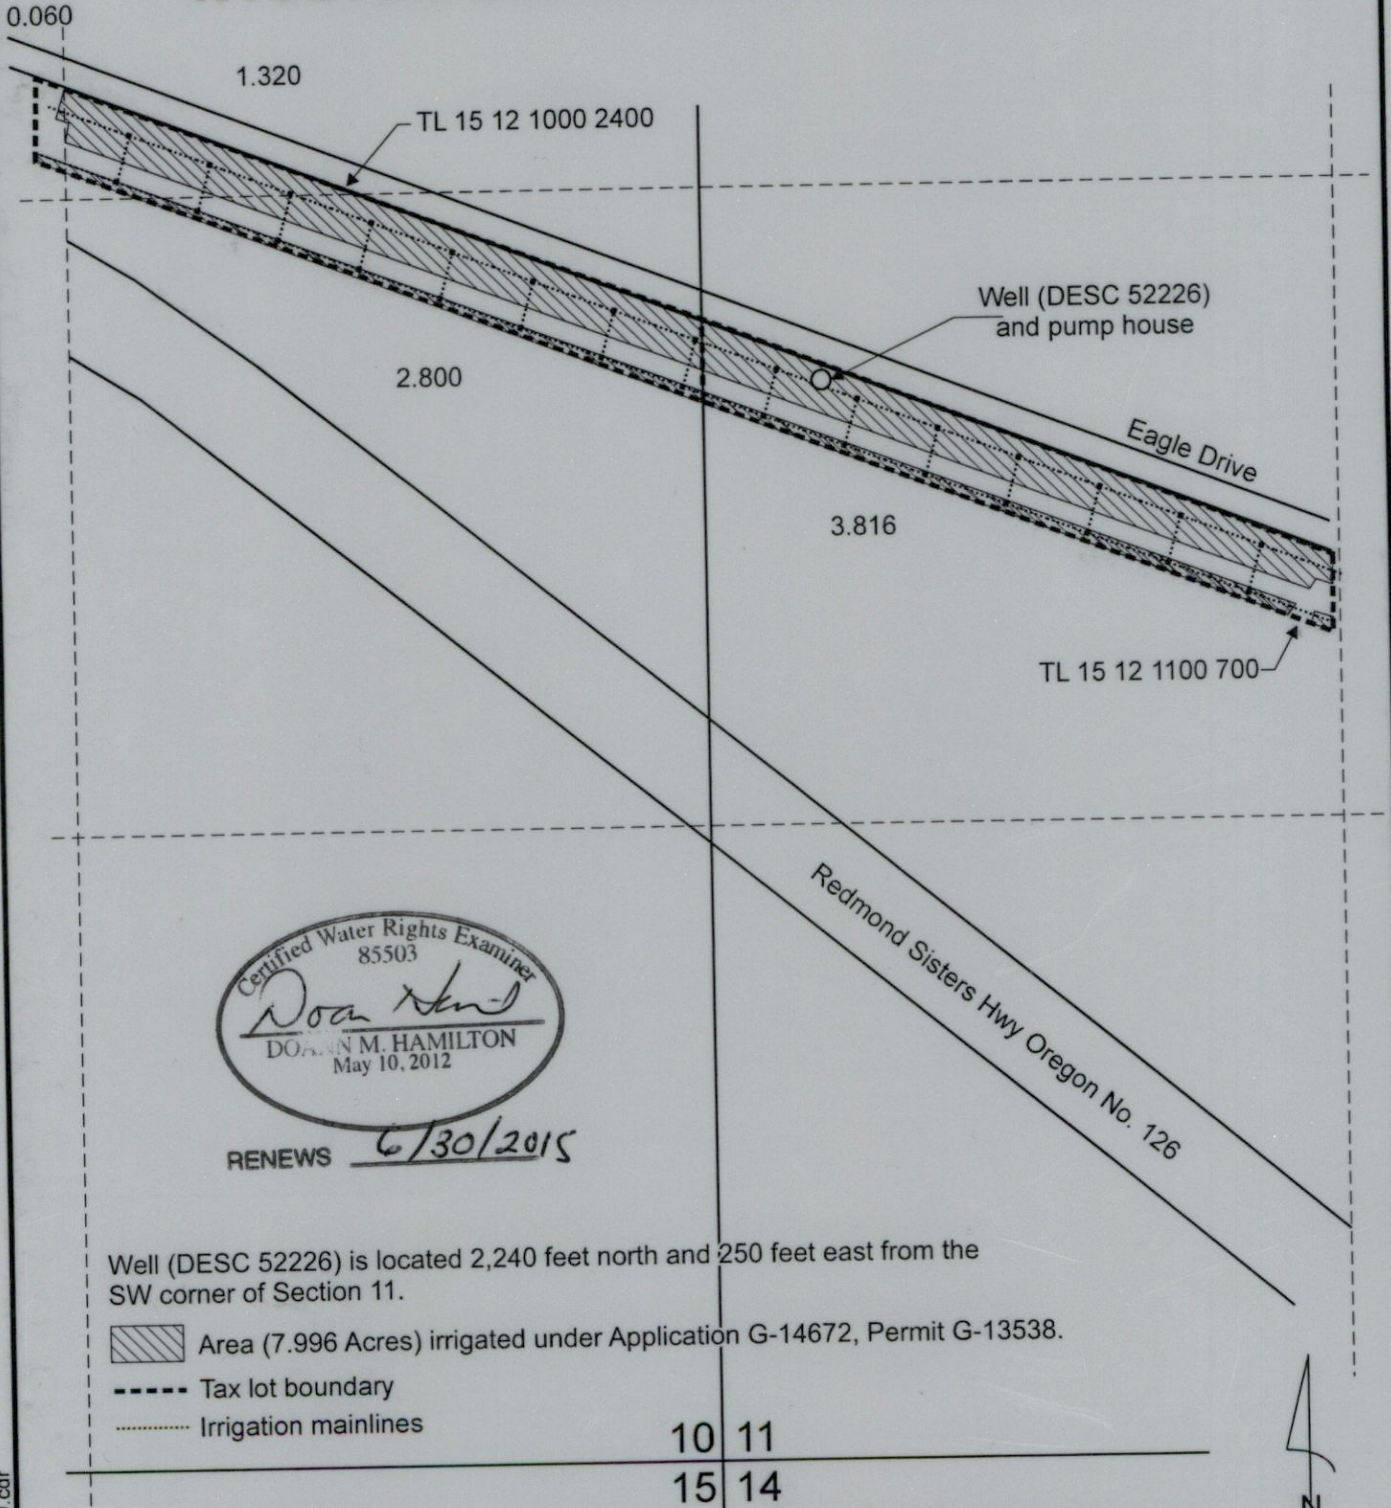


RENEWS 6/30/2015

Well (DESC 52226) is located 2,240 feet north and 250 feet east from the SW corner of Section 11.

- Area (7.996 Acres) irrigated under Application G-14672, Permit G-13538.
- Tax lot boundary
- Irrigation mainlines

Scale: 1" = 400'

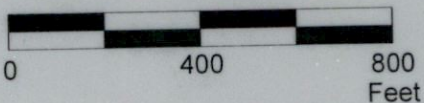

This map was prepared for the purpose of identifying the location of a water right only and is not intended to provide legal dimensions or location of property ownership lines.



Claim of Beneficial Use Map
Application G-14672, Permit G-13538

Cline Falls Airport Association
T.15S. R.12E. Sec. 10 & 11, W.M.

JUL 18 2013

Pacific Hydro-Geology Inc.

06/2013

RECEIVED
WATER RESOURCES DEPT
SALEM, OREGON