


SECTION 11 & 14, T. 39 S., R. 8 W., W.M.

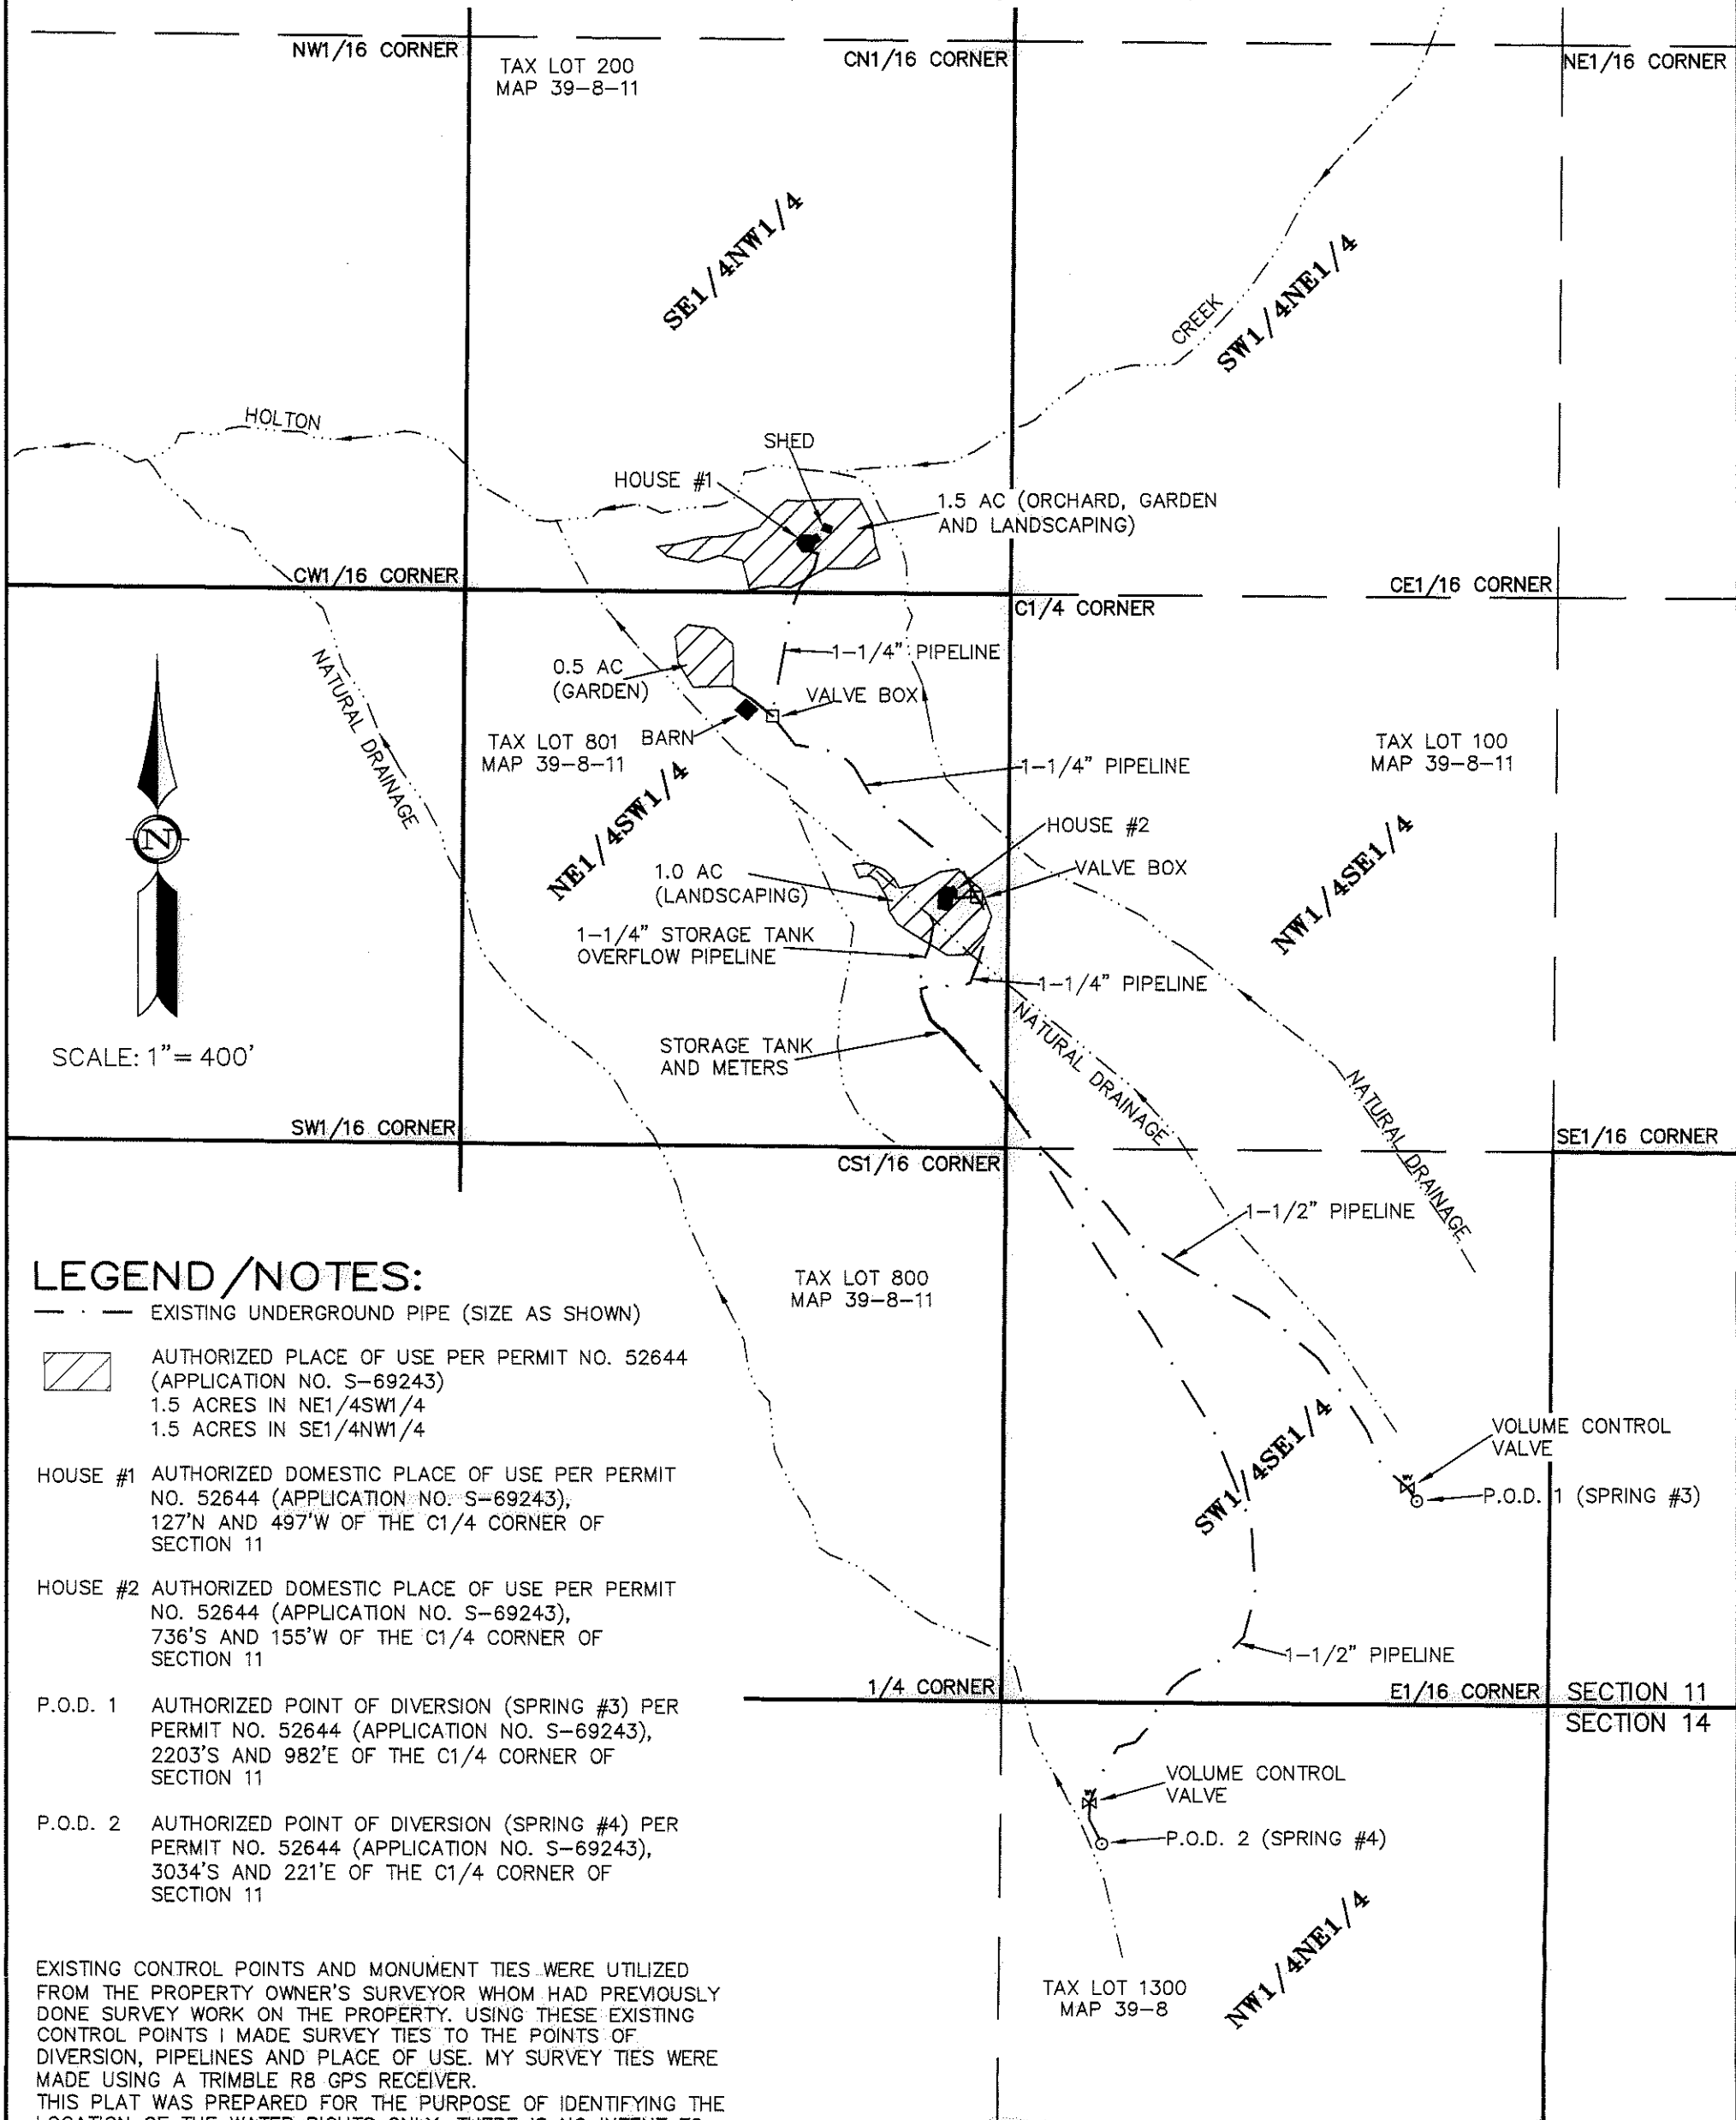

LEGEND/NOTES:

— · — · — EXISTING UNDERGROUND PIPE (SIZE AS SHOWN)



AUTHORIZED PLACE OF USE PER PERMIT NO. 52644
(APPLICATION NO. S-69243)
1.5 ACRES IN NE1/4SW1/4
1.5 ACRES IN SE1/4NW1/4

HOUSE #1 AUTHORIZED DOMESTIC PLACE OF USE PER PERMIT
NO. 52644 (APPLICATION NO. S-69243),
127'N AND 497'W OF THE C1/4 CORNER OF
SECTION 11

HOUSE #2 AUTHORIZED DOMESTIC PLACE OF USE PER PERMIT
NO. 52644 (APPLICATION NO. S-69243),
736'S AND 155'W OF THE C1/4 CORNER OF
SECTION 11

P.O.D. 1 AUTHORIZED POINT OF DIVERSION (SPRING #3) PER
PERMIT NO. 52644 (APPLICATION NO. S-69243),
2203'S AND 982'E OF THE C1/4 CORNER OF
SECTION 11


P.O.D. 2 AUTHORIZED POINT OF DIVERSION (SPRING #4) PER
PERMIT NO. 52644 (APPLICATION NO. S-69243),
3034'S AND 221'E OF THE C1/4 CORNER OF
SECTION 11

EXISTING CONTROL POINTS AND MONUMENT TIES WERE UTILIZED
FROM THE PROPERTY OWNER'S SURVEYOR WHOM HAD PREVIOUSLY
DONE SURVEY WORK ON THE PROPERTY. USING THESE EXISTING
CONTROL POINTS I MADE SURVEY TIES TO THE POINTS OF
DIVERSION, PIPELINES AND PLACE OF USE. MY SURVEY TIES WERE
MADE USING A TRIMBLE R8 GPS RECEIVER.
THIS PLAT WAS PREPARED FOR THE PURPOSE OF IDENTIFYING THE
LOCATION OF THE WATER RIGHTS ONLY. THERE IS NO INTENT TO
PROVIDE DIMENSIONS OR LOCATIONS OF PROPERTY OWNERSHIP
LINES.
A 22 PAGE REPORT ACCOMPANIES THIS PLAT.

RECEIVED BY OWRD

MAR 28 2014

SALEM, OR

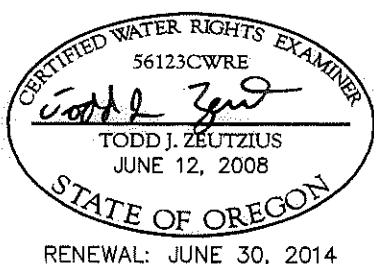

Peter D. Allen Land Surveying

321 N.W. "A" Street
Grants Pass, Oregon 97526
541-476-4502



PLAT OF CLAIM OF BENEFICIAL USE FOR 2199 & 2200 HOLTON CREEK ROAD

LOCATED IN
Maps No. 39-08-11 and 39-8
Section 11 and 14
Township 39 South, Range 8 West, W.M.
JOSEPHINE COUNTY, OREGON
SURVEY FOR
Sky & Anne Sky

GRANTS PASS, OREGON

PROJECT NUMBER:
2011-046-558

DRAWING FILE:
Sky--Holton Cr Rd.dwg

DRAWING SCALE:
1" = 400'

DATE:
MARCH 25, 2014

SHEET:
1 OF 1