


FINAL PROOF CLAIM OF BENEFICIAL USE MAP
 FOR
 CARPENTER TRUST & TOAD HALL TRUST
 LOCATED IN THE
 SE 1/4 OF SECTION 36
 TOWNSHIP 16 SOUTH, RANGE 2 EAST, W.M.
 TAX LOTS 804 & 810
 LANE COUNTY OREGON
 JANUARY 10, 2014
 APP. # S-86795, PERMIT # S-54455
 APP. # S-87353, PERMIT # S-54708

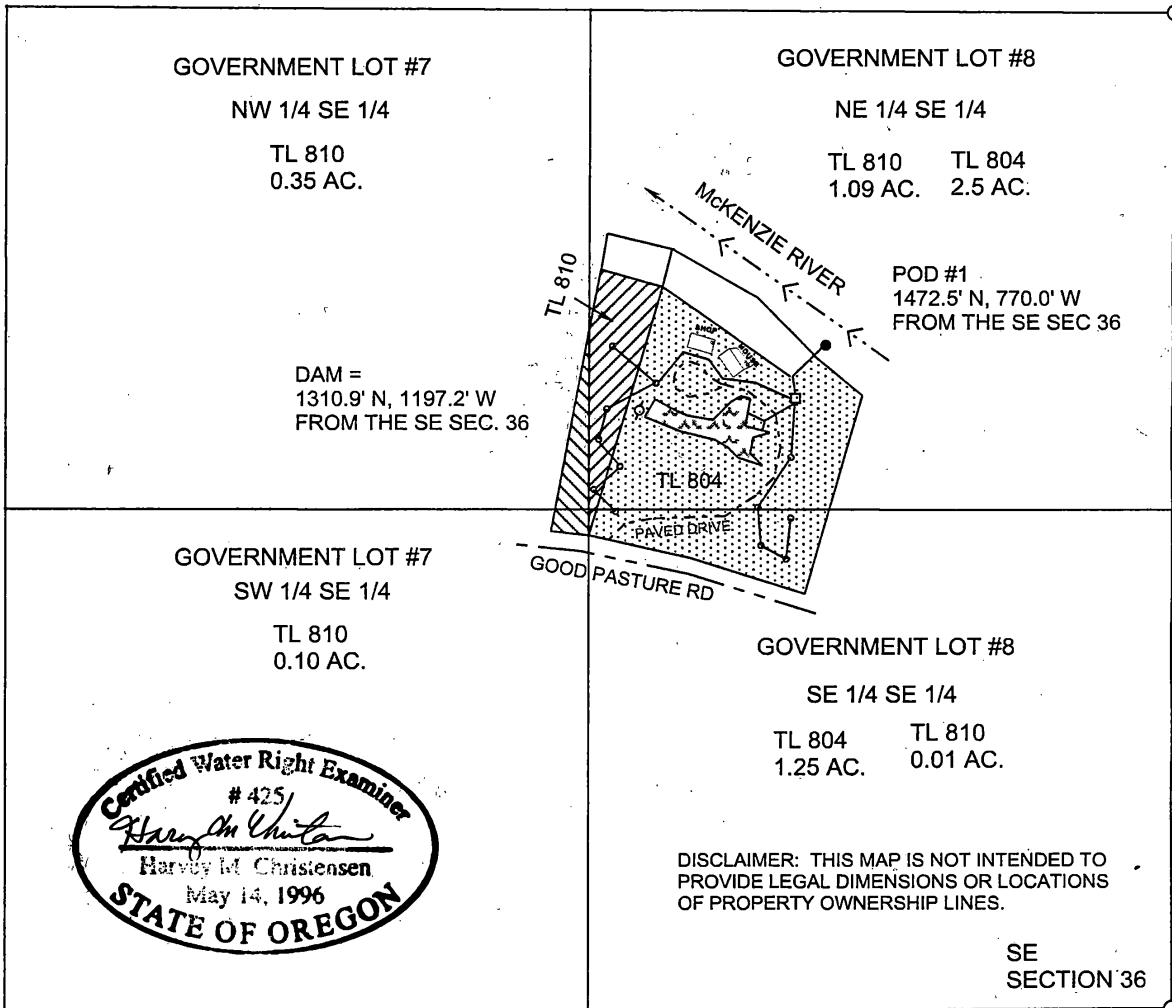

LEGEND	
●	POD #1/FISH SCREEN
□	PUMP HOUSE/METER
○	SPILLWAY DAM
—	PIPE LINE
○	HOSE BIB
	TL 804.GLOT #8
	TL 810 GLOT #7
	TL 810 GLOT #8

EAST 1/4
SECTION 36



RECEIVED BY OWRD

FEB 24 2014

SALEM, OR