



FINAL PROOF MAP

TO ADD POINTS OF APPROPRIATION &
PLACE OF USE FOR APPLICATION G-17228
WHITBY BROTHERS LAND & LIVESTOCK, LLC

TOWNSHIP 33 SOUTH, RANGE 31 EAST, SECTION 9, W.M.
TAX LOT: 1100

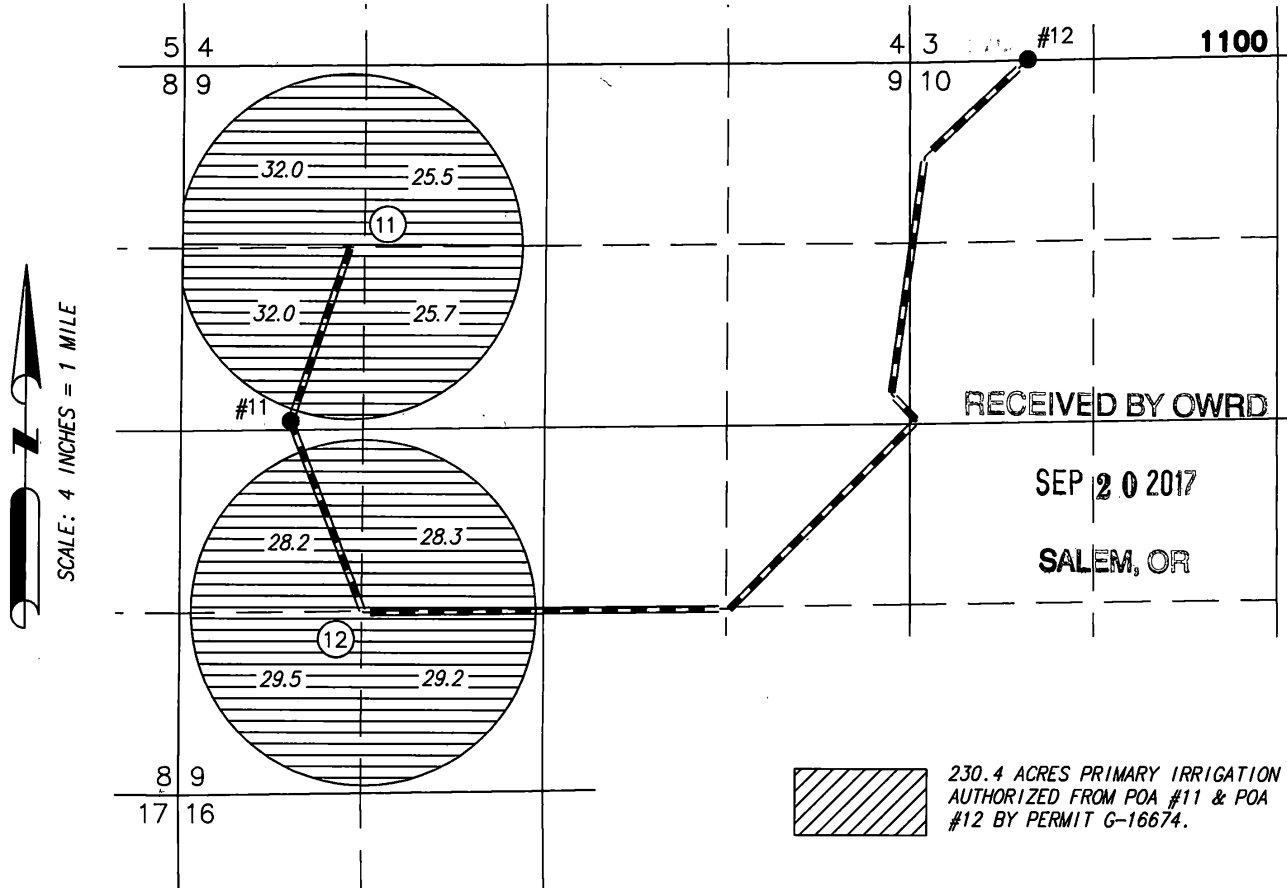

- #11 (HARN 51959)
LOCATED IN THE SW 1/4 NW 1/4 SECTION 9, T33S R31E,
W.M. AND 2730 FEET NORTH AND 800 FEET EAST FROM
THE SW CORNER OF SAID SECTION.
FLOW METER IS ON PIPE 6.0' NORTH OF WELL.
- #12 (HARN 51938)
LOCATED IN THE NW 1/4 NW 1/4 SECTION 10, T33S
R31E, W.M. AND 0 FEET SOUTH AND 860 FEET EAST
FROM THE NW CORNER OF SAID SECTION.
FLOW METER IS ON PIPE 6.0' SW OF WELL.

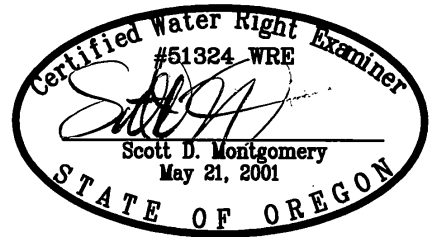

RENEWAL DATE: 12/31/2018

THIS MAP IS FOR THE PURPOSE OF LOCATING A WATER
RIGHT ONLY AND HAS NO INTENT TO PROVIDE LEGAL
DIMENSIONS OR THE LOCATION OF PROPERTY LINES.

PREPARED FOR:

WHITBY BROS. LAND/LIVESTOCK, LLC
62 W. JUNIPER ROAD
MESA, WA 99343

PREPARED BY:



ALL POINTS ENGINEERING AND SURVEYING, INC.
P.O. BOX 767
(541) 548-5833
TERREBONNE, OR 97760
www.APEandS.com