

CLAIM OF BENEFICIAL USE MAP

LOCATED IN THE NW 1/4 NW 1/4 OF SECTION 22,
TOWNSHIP 23 SOUTH, RANGE 12 WEST, W.M., COOS COUNTY, OREGON
APPLICATION S-83936, PERMIT S-53570



SCALE
1" = 200 FT.

16 15
21 22

SECTION 15
SECTION 22

SURVEY METHOD:

THE POINT OF DIVERSION WAS TIED BY TOTAL STATION TRAVERSE TO SEVERAL PROPERTY CORNERS SHOWN PER COOS COUNTY SURVEY CS3B30. THE LOCATION OF THE NORTHWEST CORNER OF SECTION 22 WAS CALCULATED FROM THESE MONUMENTS BASED ON RECORD DIMENSIONS SHOWN PER SAID SURVEY CS3B30.

TAX LOT 1001

(S36°03'24"E
NW1/4
1428.12')

TAX LOT 1000

SECTION 21
SECTION 22

EXAMINER'S DISCLAIMER STATEMENT
THE PREPARATION OF THIS MAP WAS FOR THE PURPOSE OF IDENTIFYING THE LOCATION OF THE WATER RIGHT ONLY AND HAS NO INTENT TO PROVIDE DIMENSIONS OR LOCATION OF PROPERTY OWNERSHIP LINES.

OUTBUILDING
CONTAINING
PRESSURE TANK &
FILTRATION

HOUSE,
PLACE OF USE

175 FEET OF
1" POLY PIPE

LEGEND

- ⊙ POINT OF DIVERSION
- 1" POLY PIPE
- ⊙ FOUND MONUMENT PER PLAT
- CALCULATED CORNER POSITION
- () RECORD DIMENSION

TAX LOT 1100

(N57°17'22"E
262.20'
(262.66')
NW1/4
SW1/4 NW1/4

POINT OF DIVERSION LOCATION:
THE POINT OF DIVERSION BEARS
S37°11'54"E 1532.24' FROM THE
NORTHWEST CORNER OF SECTION 22.

POD


A 1/2 HP SCREENED
INTAKE, SUBMERSIBLE PUMP
MOUNTED TO A DOCK
WITHIN TENMILE LAKE

TENMILE LAKE

RECEIVED BY OWRD

NOV 12 2014

SALEM, OR

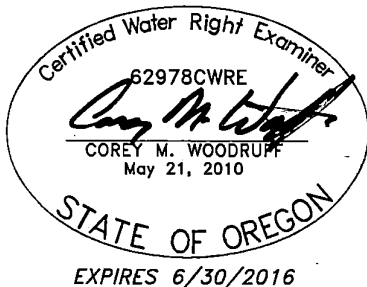

705 S. 4TH ST.
P.O. BOX 118
COOS BAY, OREGON 97420

PHONE: (541) 267-2872
FAX: (541) 267-0588
www.stuntzner.com

Engineering - Land Surveying - Forestry - Land Planning - Water Rights

JOB #: 114-119

DATE: Sept. 2014

DRAWN BY: CMW

CHECKED BY: CMW

PREPARED

FOR:

Fred Pederson
Lakeside, OR

FILE NAME: 114-119 Pederson.dwg

SHEET 1 OF 1