
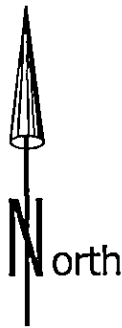


CLAIM OF BENEFICIAL USE


T.17 S., R.5 W., W.M. SECTION 5

RICHARDSON D.L.C. # 42

FOR: EUGENE YACHT CLUB

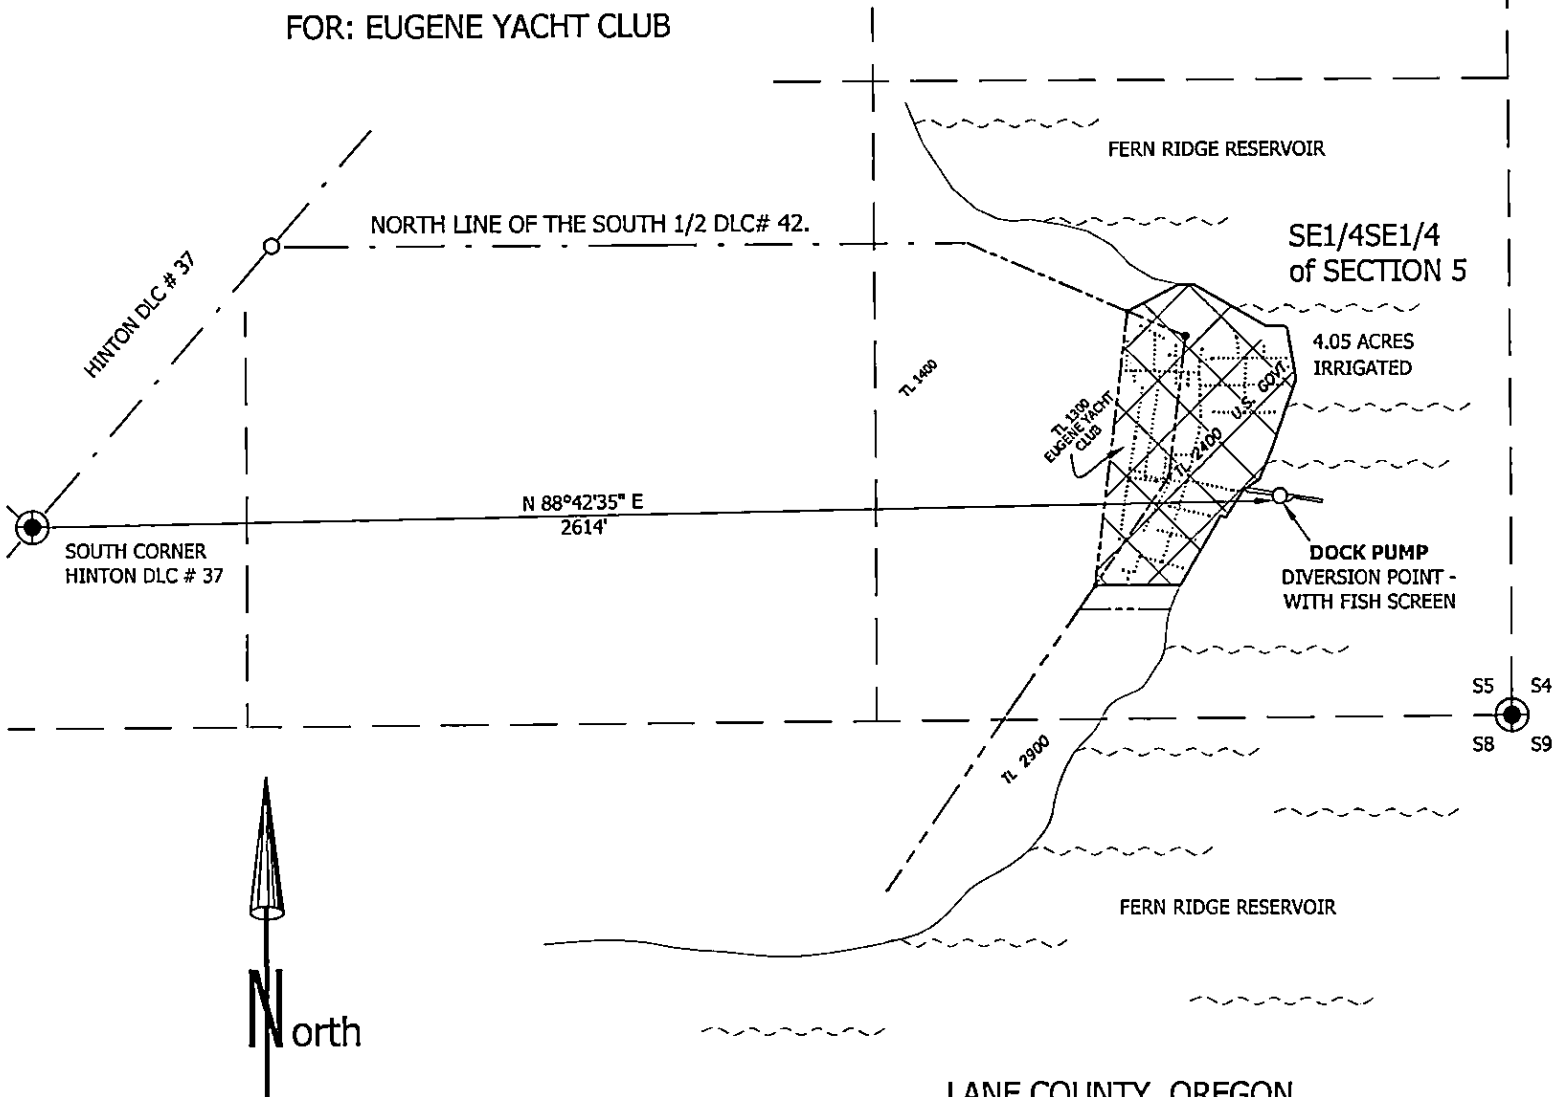


LEGEND

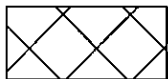

IRRIGATED ACRES



D.L.C. & SECTION CORNER

 

SECTION LINE



D.L.C. LINE




WATER PIPELINE



PROPERTY LINE

SCALE: 1 INCH = 400 FEET

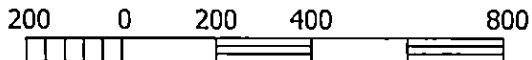

LANE COUNTY, OREGON

MAP# 17-05-05 IN TL# 1300 & 2400.

PRIORITY DATE: AUGUST 22, 1991

APPLICATION No. S-71808

PERMIT No. S-53577


RECEIVED BY OWRD

MAY 22 2014

SALEM, OR

THIS MAP IS NOT
INTENDED TO PROVIDE
LEGAL DIMENSIONS OR
LOCATION OF PROPERTY
OWNERSHIP LINES.

DONN ROWE LLC
(541) 953-7778
90946 SUNDERMAN ROAD
SPRINGFIELD, OR. 97478

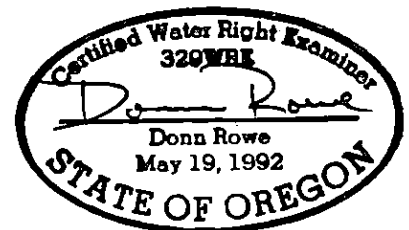

RENEWAL DATE: 12-31-2014