


T.3S. R.4E. Sec. 15 & 16, W.M.

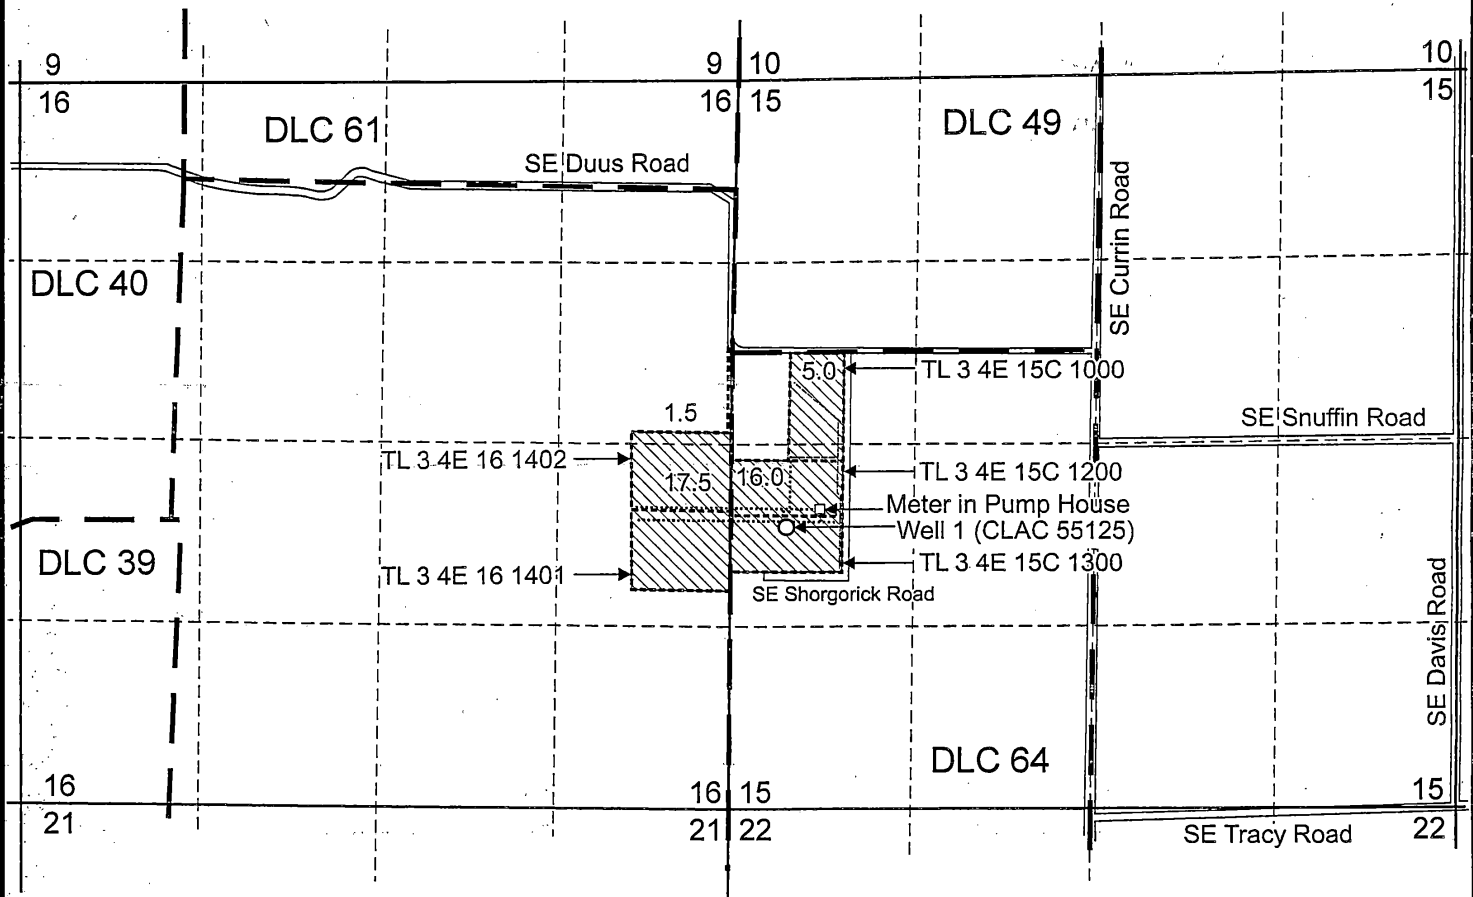

Well 1 (CLAC 55125) is located 600 feet south and 400 feet east from the W1/4 corner, Section 15.

The meter is located in the pump house 130 feet north and 245 feet east from Well 1 (CLAC 55125).



-  Area (40.0 Acres) of nursery use under Application G-14881, Permit G-13744.
-  2-inch Buried Mainline
-  3-inch Buried Mainline
-  Tax Lot Boundary
-  Donation Land Claim (DLC) Boundary

RECEIVED

NOV 25 2014

WATER RESOURCES DEPT
SALEM, OREGON

Scale: 1" = 1,320'

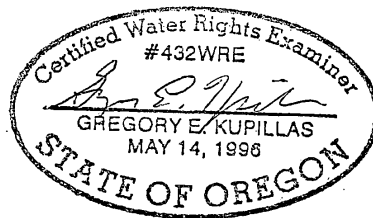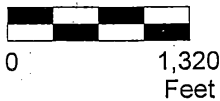

EXPIRATION DATE: 6/30/2015

This map was prepared for the purpose of identifying the location of a water right only and is not intended to provide legal dimensions or location of property ownership lines.

Claim of Beneficial Use Map
Application G-14881, Permit G-13744

Rickel's Tree Farm LLC/Bobby Daniel Rickel
T.3S. R.4E. Sec. 15 & 16, W.M.

Pacific Hydro-Geology Inc.

2014 - bgp