

**LEGEND**


	SECTION LINE
	1/4 1/4 LINE
	TAX LOT LINE
	DITCH LINE
	BURIED PIPE
	ROAD
	SECTION CORNER
TL 0000	TAX LOT NUMBER
GL 0000	GOV'T LOT NUMBER
	PUMP
	POA (WELL)
	AREA INCLUDED IN WATER RIGHT

RECEIVED BY OWRD

DEC 01 2014

SALEM, OR

*Jane Parken*  
APPLICANT

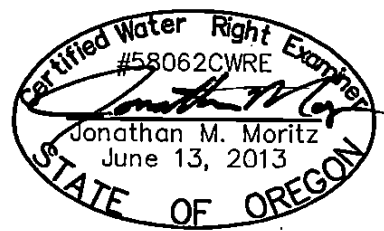

RENEWAL 12/31/14

**WELL TIE**

POA 1: 1340' NORTH & 160' WEST FROM THE EAST QUARTER CORNER OF SECTION 25, T37S, R8E, W.M.

**NOTES**

1. THIS MAP WAS PREPARED FROM FIELD MEASUREMENTS AND KLAMATH COUNTY TAX MAPS T37S, R8E, SEC. 25 & T37S, R9E, SEC. 30.
2. THIS MAP IS FOR THE PURPOSE OF IDENTIFYING THE LOCATION OF THE WATER RIGHT ONLY AND HAS NO INTENT TO PROVIDE DIMENSIONS OR LOCATION OF PROPERTY LINES.
3. FOR TAX LOT INFORMATION, SEE TAX MAPS INCLUDED WITH THIS COBU.
4. DATE OF PRIORITY FOR THIS APPLICATION IS MARCH 19, 1998.

**ADKINS**

CONSULTING ENGINEERING, LLP

Engineers ▲ Planners ▲ Surveyors

2950 Shasta Way · Klamath Falls, Oregon 97603 · (541) 884-4666 · FAX (541) 884-5335  
Oregon · California

**CLAIM OF BENEFICIAL USE AND FINAL PROOF MAP**

FOR  
KLAMATH CASCADE GROUP, LLC  
T37S, R8E, SEC. 25, & R9E, SEC. 30 WM  
KLAMATH COUNTY, OREGON  
PERMIT No. G-13585  
APPLICATION No. G-14715