

RECEIVED BY OWRD

MAR 19 2013


SALEM, OR

CLAIM OF BENEFICIAL USE MAP

SECTION 25, T3S, R3E, WM
LOTS 301, 600 AND 601 OF TAX MAP T3S R3E SEC. 25, LOCATED IN DLC 51
CLACKAMAS COUNTY, OREGON
APPLICATION R-70935 (PERMIT R-11855)

PREPARED FOR:


JAMES OSTERMAN
22329 S. CLEAR CREEK ROAD
ESTACADA, OREGON 97023

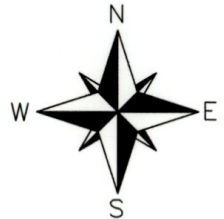

LEGEND

- SECTION CORNER
- POD/DAM CENTERLINE
- PROPERTY LINE
- TAXLOT LINE
- SECTION LINE
- 16TH LINE
- CREEK
- DLC LINE
- RESERVOIR

0 1320 2640
1 inch = 1320 ft.

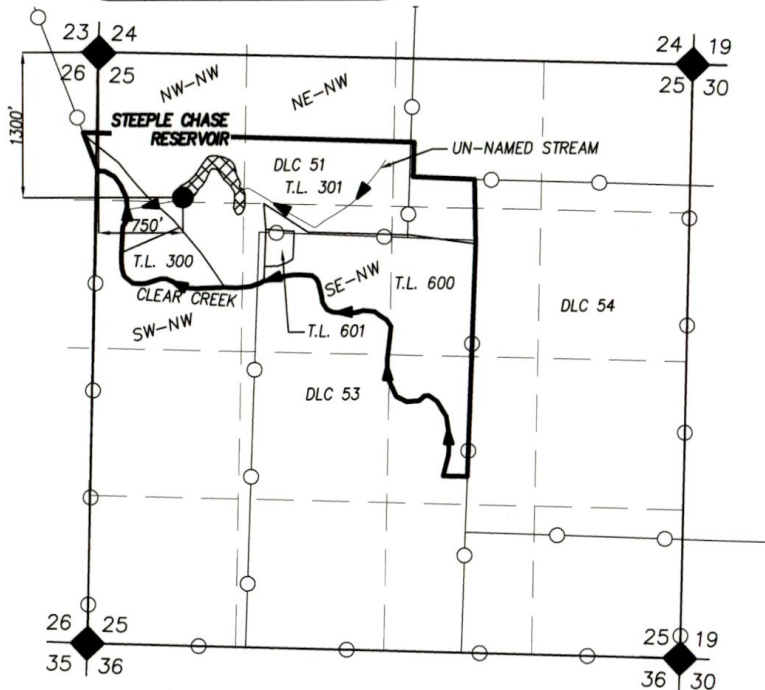

MAP BASES: CLACKAMAS COUNTY TAX MAP T3S R3E SEC. 25
2011 AERIAL PHOTO FROM GOOGLE EARTH

THIS MAP WAS PREPARED FOR THE PURPOSE OF IDENTIFYING THE LOCATION OF A
WATER RIGHT ONLY AND IS NOT INTENDED TO PROVIDE LEGAL DIMENSIONS OR
LOCATION OF PROPERTY OWNERSHIP LINES.



EXPIRES 06/30/2014



Project: 310-2-082
By: DYLAN HITNER
Checked by: ERIC URSTADT
Date: MARCH 7, 2013