
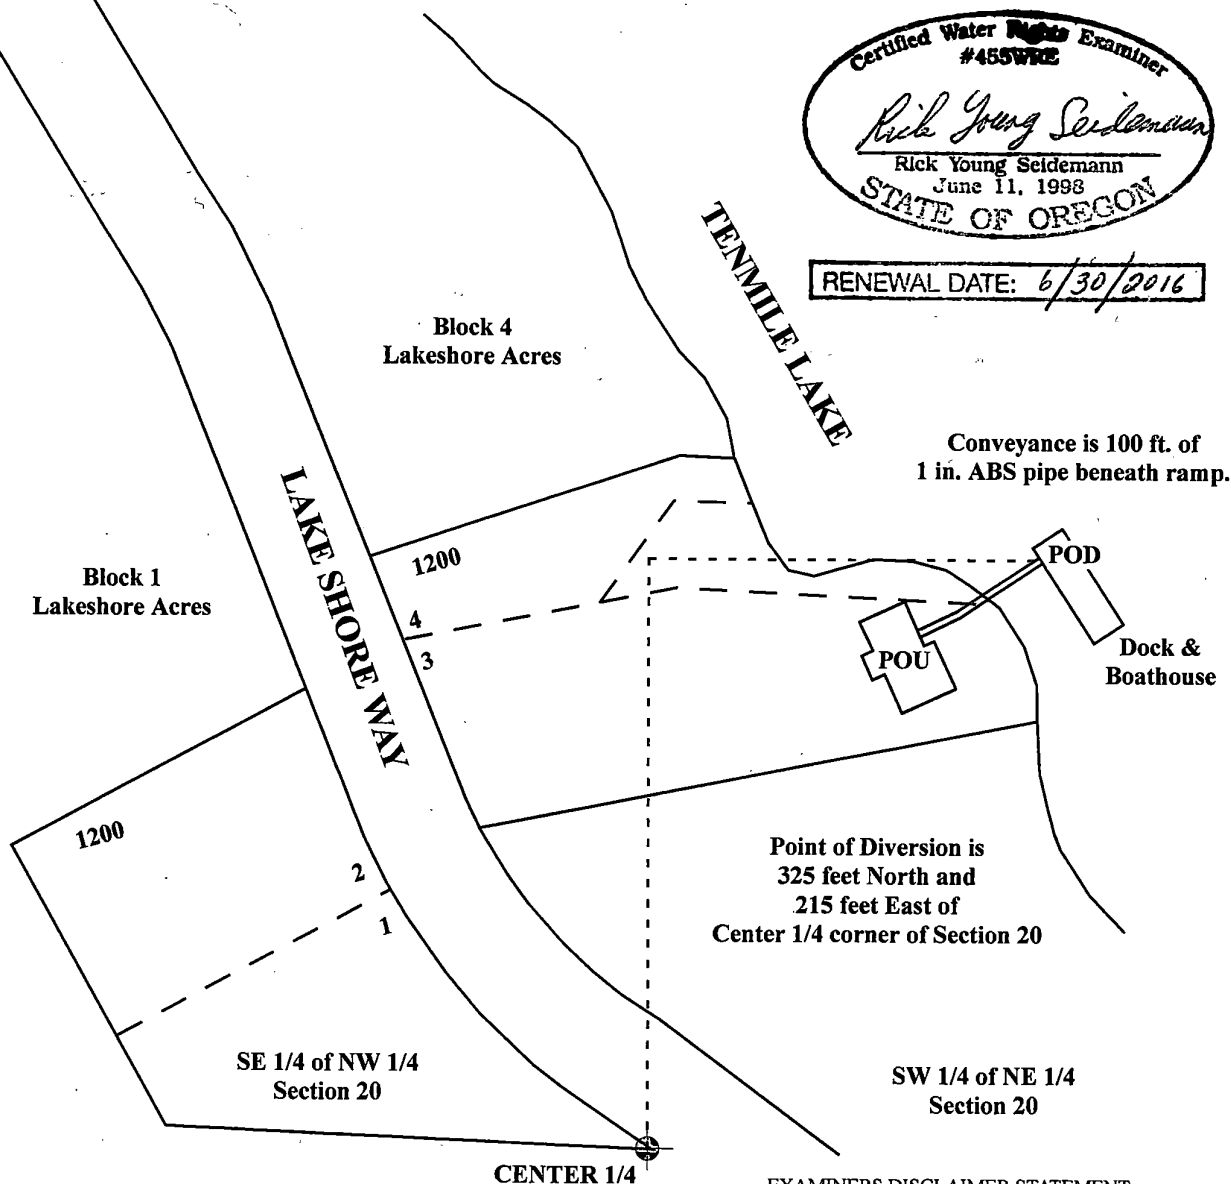


**Located in the SW 1/4 of NE 1/4 of Section 20
T23S, R12W, W. M., Coos County, Oregon**

AN

Prepared By: RYS Environmental LLC
Date Prepared: 25 July 2014

Scale: 1 in. = 100 ft.

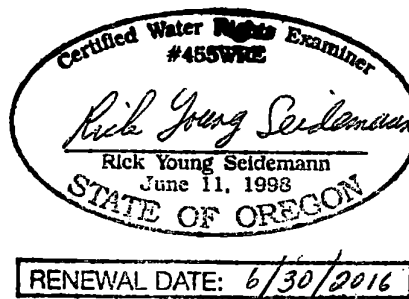

The preparation of this map was for the purpose of identifying the location of the Water Right only and has no intent to provide dimensions of location of property ownership lines.