


RECEIVED

SEP 23 1993

WATER RESOURCES DEPT.
SALEM, OREGON


T10S, R21E, W.M.

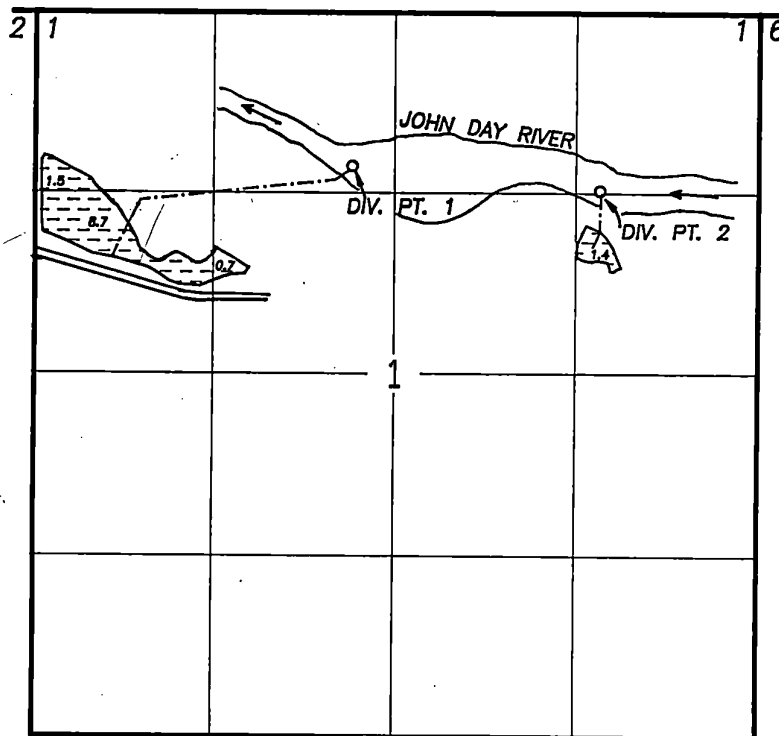

SCALE 1"=1320'

Diversion Point No. 1 is 1110' S. and 2320' E. of the NW cor. Sec. 1
Diversion Point No. 2 is 1290' S. and 4130' E. of the NW cor. Sec. 1

FINAL PROOF SURVEY
UNDER

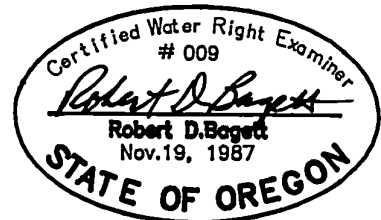

TRANSFER NO. 6345

APPLICATION NO. _____ ORDER VOL. 44, PAGE 471

IN NAME OF
JOHN AND SHERLA COLLINS
SURVEYED SEPT. 10, 1993 BY Robert D. Baggett

NOTE: The preparation of this map
was for the purpose of identifying
the location of the proposed water
right and has no intent to provide
dimensions or location of property
ownership lines.