


T. 25S., R. 6 W., W. M.

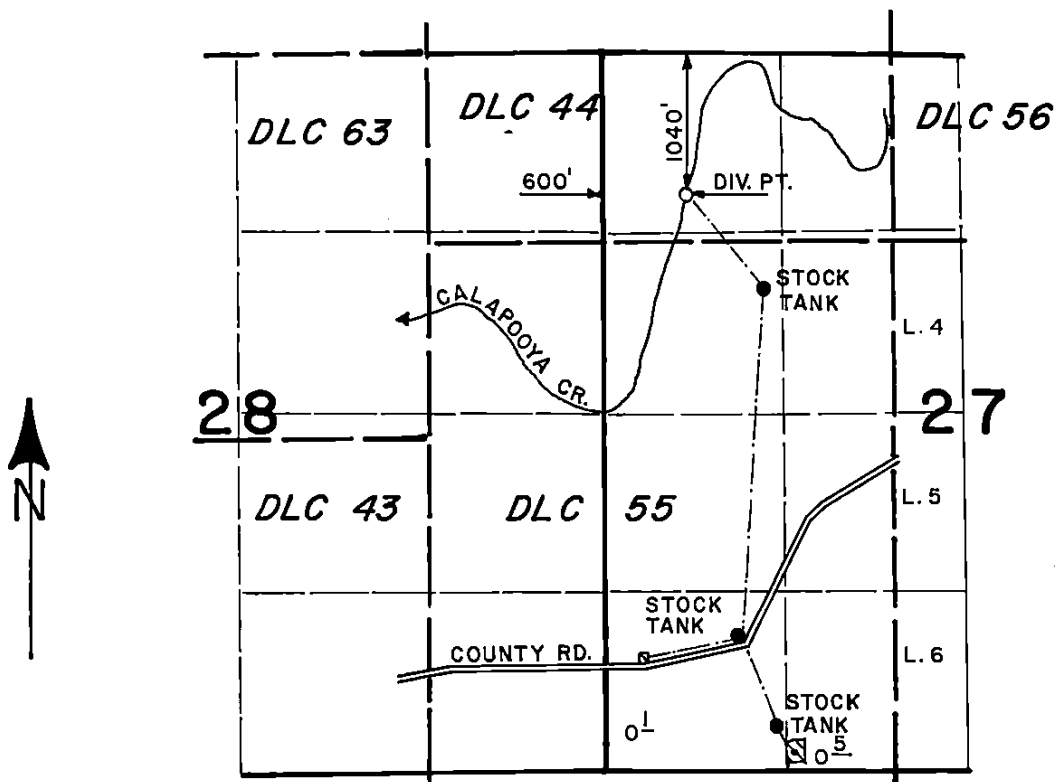

SCALE: 4" = 1 MILE

FINAL PROOF SURVEY

UNDER

TRANSFER NO. T-4369

IN NAME OF

HAROLD CROUCH

Surveyed JULY 28, 1986., by J. M. SCHMORDE.