


18 | 17  
19 | 20

SALEM, OR

**LEGEND**

	SECTION LINE	TL 0000	TAX LOT NUMBER
	1/4 1/4 LINE		POA (WELL)
	TAX LOT LINE	18   17	SECTION CORNER
	ROAD	19   20	AREA INCLUDED IN WATER RIGHT

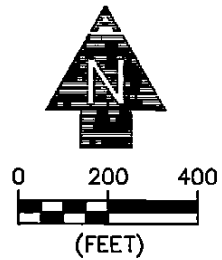


**WELL TIE**

POA 1: 1315' NORTH & 1798' WEST OF THE SOUTHEAST CORNER OF SECTION 18, T38S, R9E, W.M.

**NOTES**

1. THIS MAP WAS PREPARED FROM FIELD MEASUREMENTS AND KLAMATH COUNTY TAX MAP T38S, R9E, SEC. 18.
2. THIS MAP IS FOR THE PURPOSE OF IDENTIFYING THE LOCATION OF THE WATER RIGHT ONLY AND HAS NO INTENT TO PROVIDE DIMENSIONS OR LOCATION OF PROPERTY LINES.
3. FOR TAX LOT INFORMATION, SEE TAX MAP INCLUDED WITH THIS COBU.
4. DATE OF PRIORITY FOR THIS APPLICATION IS MARCH 19, 1998.

*Jane Rankin*  
APPLICANT

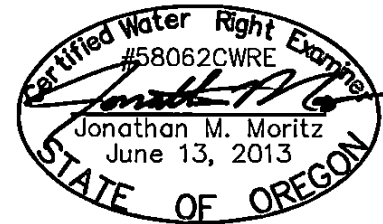

RENEWAL 12/31/14

**ADKINS**

CONSULTING ENGINEERING, LLP  
Engineers ▲ Planners ▲ Surveyors  
2950 Shasta Way · Klamath Falls, Oregon 97603 · (541) 884-4666 · FAX (541) 884-5335  
Oregon · California

11/25/14

2471-02

**CLAIM OF BENEFICIAL USE AND FINAL PROOF MAP**

FOR  
KLAMATH CASCADE GROUP, LLC  
T38S, R9E, SEC. 18, WM  
KLAMATH COUNTY, OREGON  
PERMIT No. G-13586  
APPLICATION No. G-14718