


SECTION 6, T 36 S, R 1 W, WM.
JACKSON COUNTY, OREGON
ASSESSOR'S MAP No 361W6


RECEIVED BY OWRD CLAIM OF BENEFICIAL USE
APPLICATION S-87681 PERMIT S-54711
NOV 07 2014 CENTRAL POINT SCHOOL DISTRICT #6
SALEM, OR

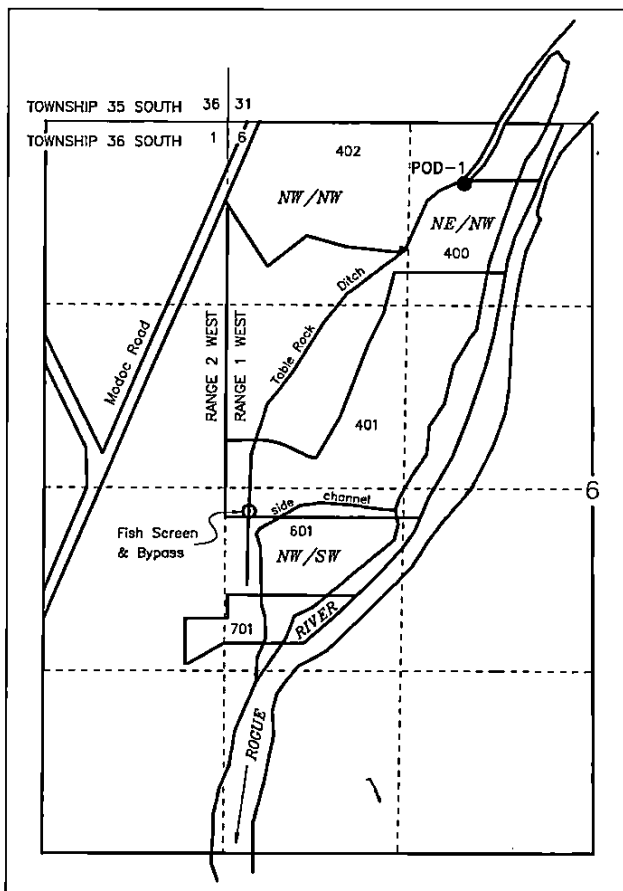

- POD-1 - NE/NW Section 6, 440 feet South & 1730 feet East from the NW corner of Section 6


(Base map for POD - recorded survey CS-18604 over Oregon Map aerial photo downloaded 9/29/2014 and Jackson County GIS tax lots)

SECTION 28, T 35 S, R 2 W, WM.
JACKSON COUNTY, OREGON
ASSESSOR'S MAP No 352W28-1100

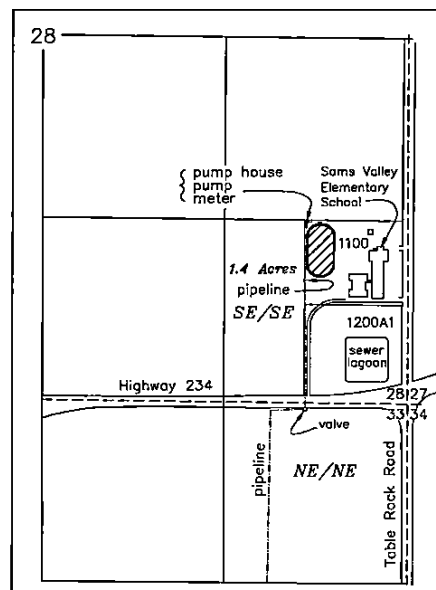

Irrigation of 1.4 Acres
Source- Lost Creek Lake Reservoir
(Permits R-8141 & R-8142)

This map is not intended to provide legal dimensions or locations of property ownership lines

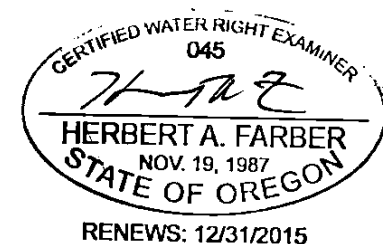

LEGEND

SCALE: 1" = 1320'
0' 660' 1320' 2640'

Prepared by:
FARBER & SONS, INC.
dba FARBER SURVEYING
(541) 664-5599

PO BOX 5286
431 OAK STREET
CENTRAL POINT, OREGON 97502

DATE: OCTOBER 8, 2014

JOB NO. 2279-14

FILE: JOBS\sams valley\meadows\dist 6 cobu\filename.dwg