
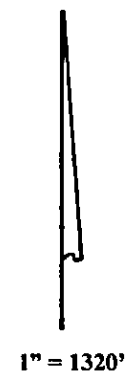


T.3S., R.1W., W.M.

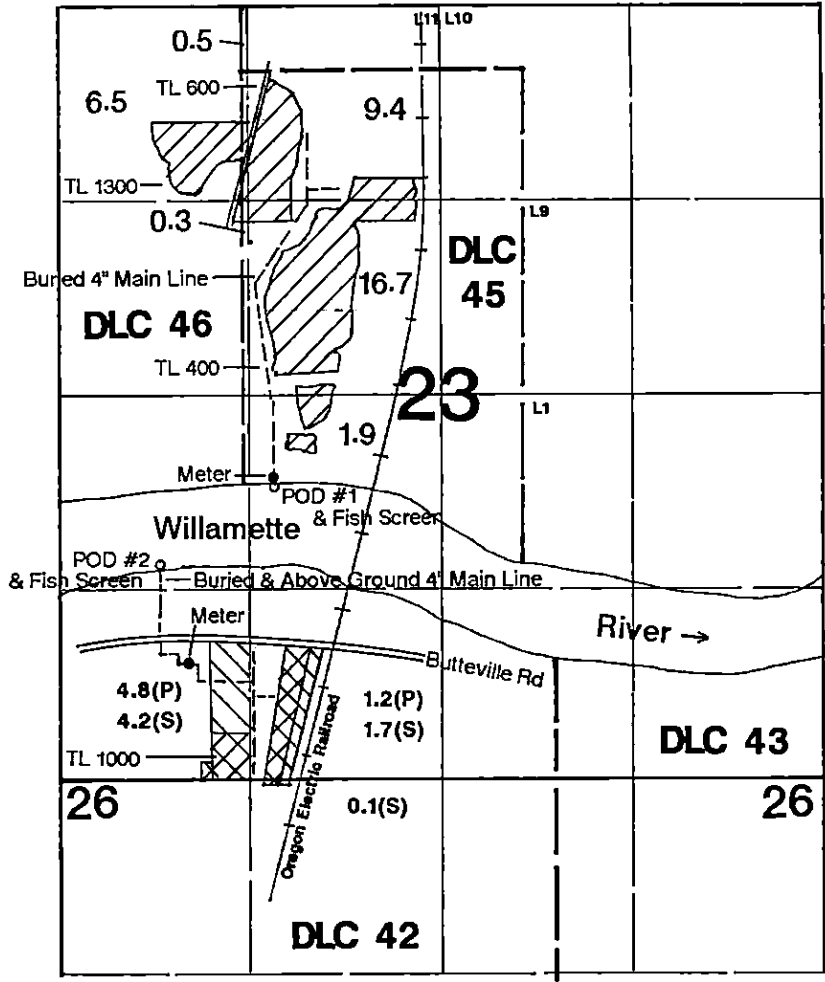

Water from Willamette River Basin Storage Projects

POD #1 is located 2050' N & 1480' E from the SW corner of Section 23. (NE1/4 SW1/4, Sec.23)
 POD #2 is located 1480' N & 705' E from the SW corner of Section 23. (NW1/4 SW1/4, Sec.23)

Final Proof Survey

In the Name of

Bernert Nursery

Application #: S-86202 Permit #: 54227

Surveyed on May 20, 2013 by JM Schuette

This Map was Prepared for the Purpose of Identifying the Location of a Water Right Only and is Not Intended to Provide Legal Dimensions or Location of Property Ownership Lines.