
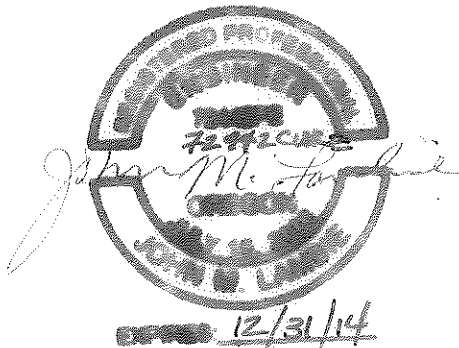


876

STREAM WATER RIGHTS IN TOWNSHIP 2 N 1 E Section (s) 32

Application S 85864 Permit S 54140

1" = 400 FEET

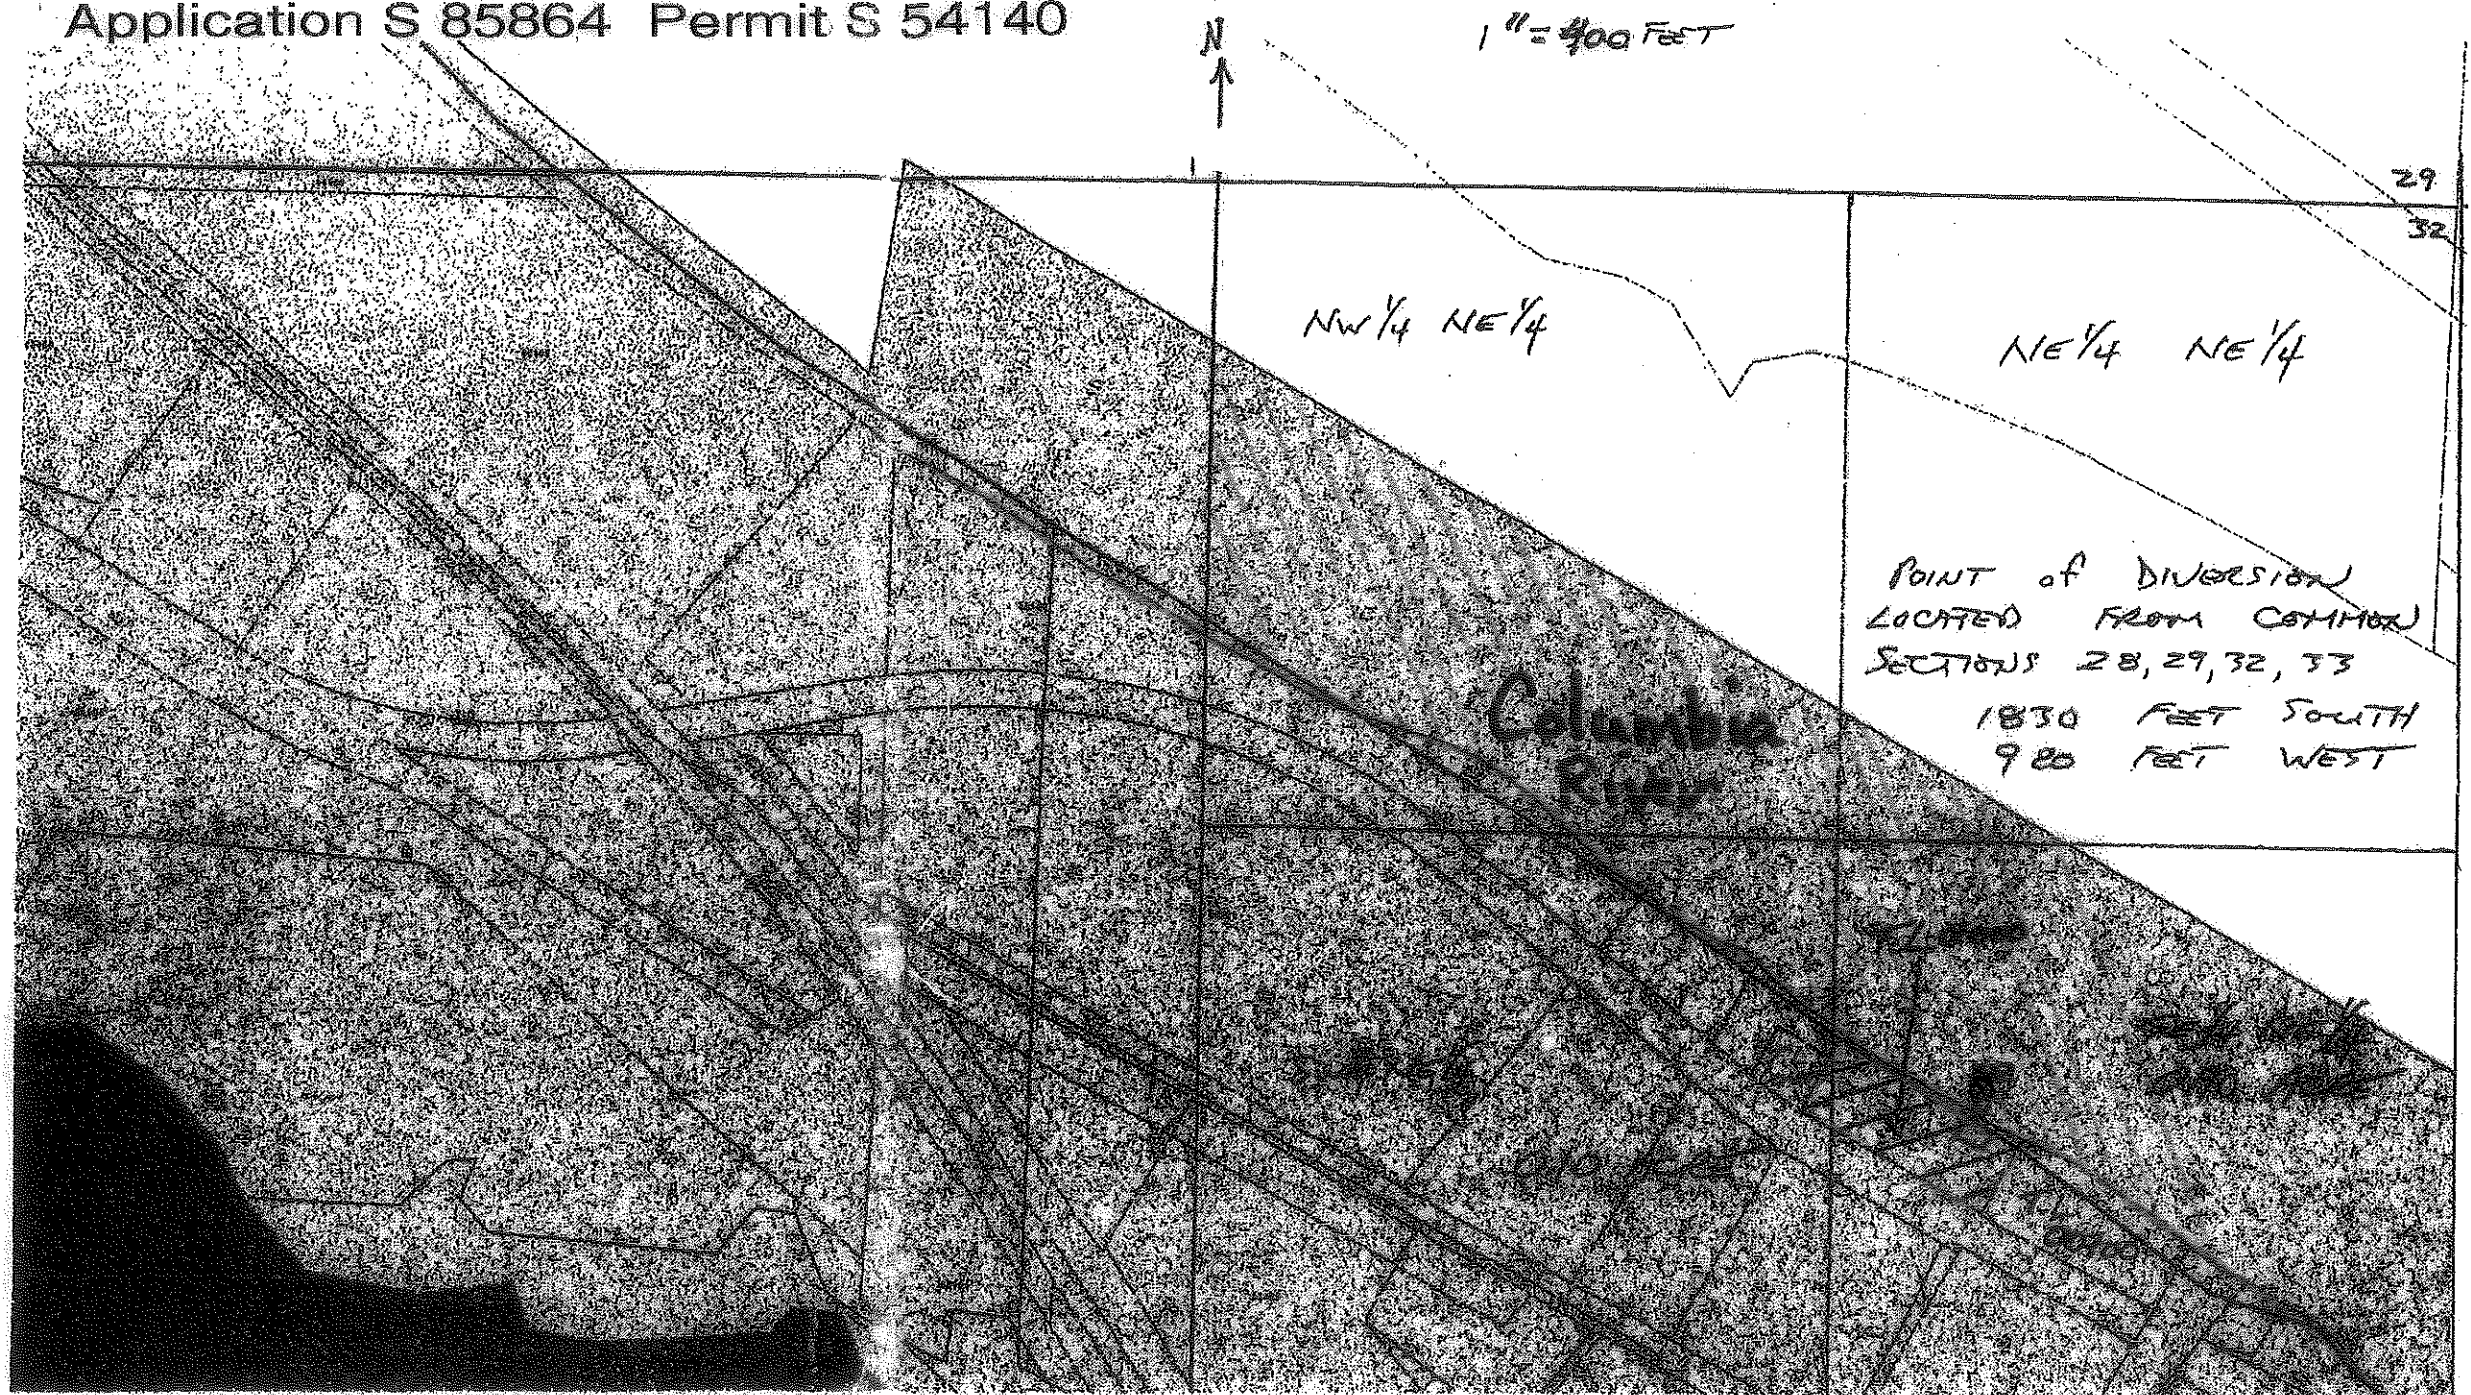

This map is not intended to provide legal dimensions or locations of property ownership lines

LEGEND

- ⊙ Point of Diversion
- ☒ Fish Screen and Pump
- ▨ Irrigated Taxlot 01000
- ▨ Source - Columbia River
- Control House
- Pipelines
- * Flow Meter

COBU MAP # 876