

CLAIM OF BENEFICIAL USE FINAL PROOF MAP



Located in the SW1/4 SW1/4 of Section 9
Township 23 South, Range 12 West, W.M.
Coos County, Oregon
Application S-81472 Permit 53206

Prepared For: Clark Wilson
Prepared By: Dennis Goude
Date Prepared: June 26, 1998

LEGEND

P.O.B. ●

P.O.D. ⚡

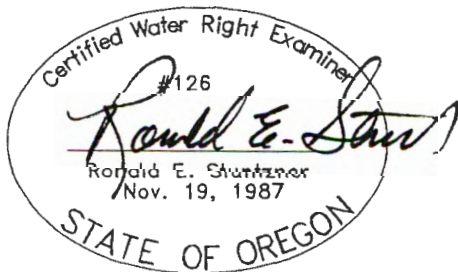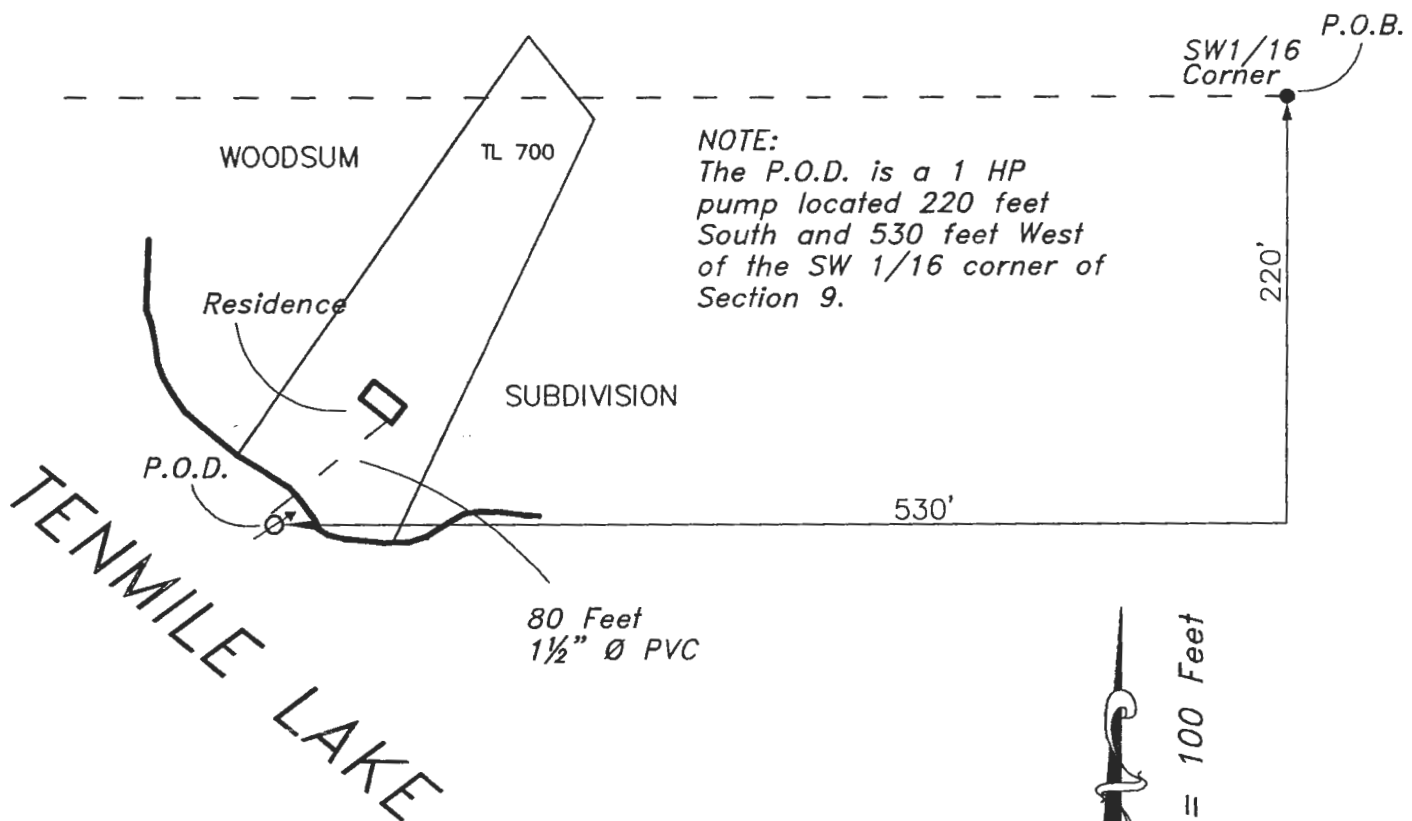

EXPIRES 06/30/00

RECEIVED BY OWRD

MAY 15 2013

SALEM, OR

Stuntzner Engineering
& Forestry, L.L.C.

ENGINEERING • LAND SURVEYING • FORESTRY
PLANNING • WATER RIGHTS

705 South 4th St.
Post Office Box 118
Coos Bay, Oregon 97420

Phone: (541) 267-2872
Fax: (541) 267-0588

EXAMINERS DISCLAIMER STATEMENT

The preparation of this map was for the purpose of identifying the location of the Water Right only and has no intent to provide dimensions or location of property ownership lines.