

CLAIM OF BENEFICIAL USE


LOCATED IN THE NW¼ OF SECTION 27,
T.31S., R.15W., W.M., CURRY COUNTY, OREGON

THE PREPARATION OF THIS MAP WAS FOR THE
PURPOSE OF IDENTIFYING THE LOCATION OF THE
WATER RIGHT ONLY AND HAS NO INTENT TO PROVIDE
DIMENSIONS OR LOCATION OF PROPERTY OWNERSHIP.


PREPARED FOR:
SANDRA CLARK

APPLICATION: S-73471
PERMIT: S-53005

SCALE 1" = 400 Ft.

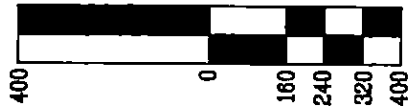

TOTAL ACREAGE IRRIGATED
12.25 AC.

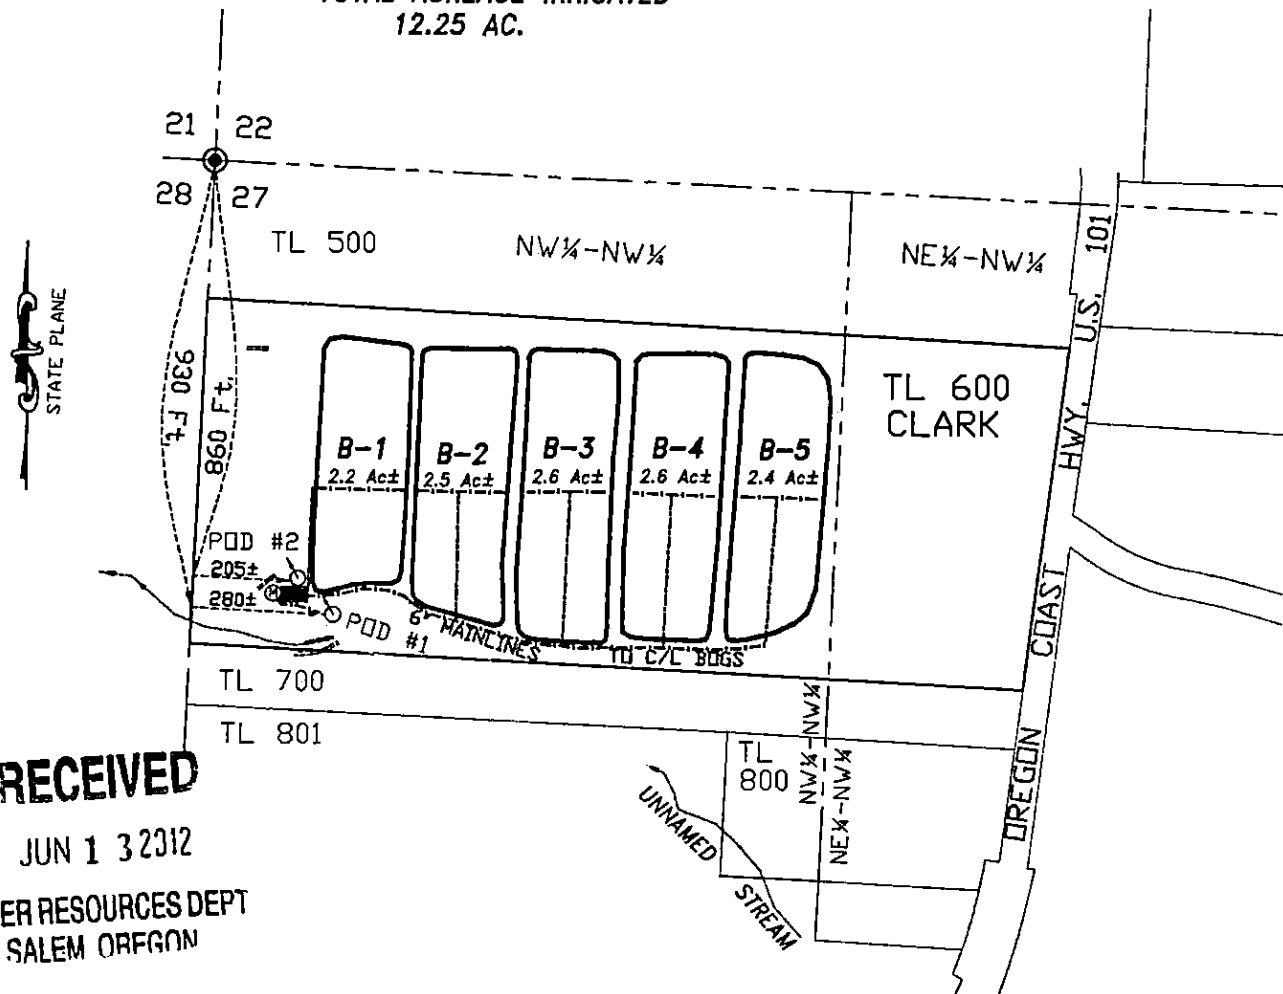

RECEIVED

JUN 1 3 2012

WATER RESOURCES DEPT
SALEM OREGON

LEGEND

- PIPELINES (MAINLINES)
- POINT OF DIVERSION (PUMP STATION)
- PUMP SPRINKLER CONTROL BUILDING & TELEMTRY
- ⊗ TOTALIZING FLOWMETER TO BOGS
- == 18" ABS PIPE (2) SPILLWAY OVERFLOW AND OUTLET PIPING
- GOVT. SECTION CORNER



Stuntzner Engineering & Forestry, L.L.C.

ENGINEERING • LAND SURVEYING FORESTRY
PLANNING • WATER RIGHTS

705 South 4th St.
Post Office Box 118
Coos Bay, Oregon 97420
Phone: (541) 267-2872
Fax: (541) 267-0688

Drawn By: Evin Stingley	Date: 12/14/2011
Checked By: TMH	Drawing No.: 11-105 Clark
Designed By: TMH	Revised: 6/04/2012
Job Name: Sandra Clark COBU Map	Sheet 2 of 2