


EXHIBIT B

T23S, R36E, W.M.
Harney County, Oregon

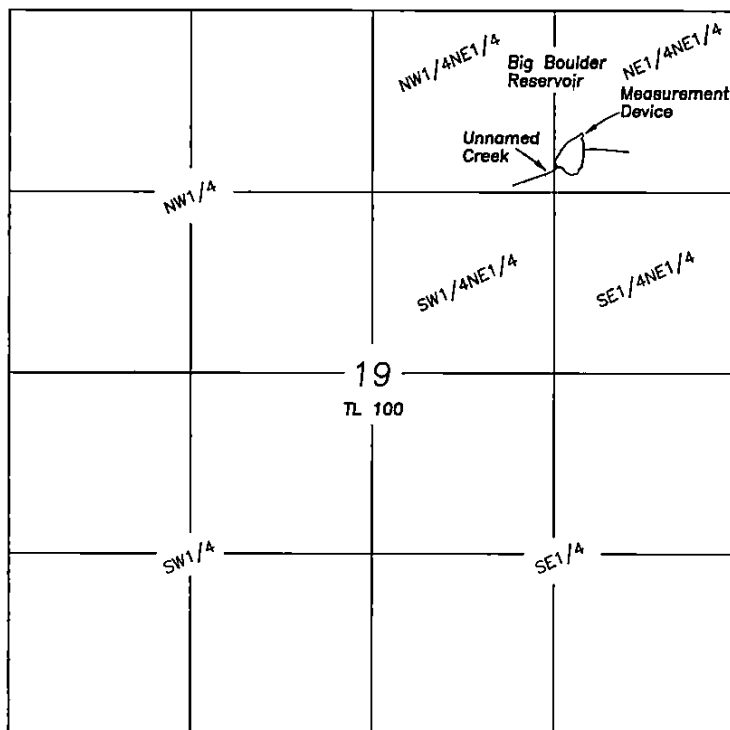

SCALE 1"=1320'

Outlet is located 900' South & 1110' West of the
NE corner of Section 19.

Measuring device is located 15' South of the outlet

FINAL PROOF SURVEY
CLAIM OF BENEFICIAL USE
BIG BOULDER RESERVOIR

For

Bureau of Land Management

September 15, 2017

Prepared by

Cornerstone Surveying, Inc

P.O. BOX 33

JOHN DAY, OR. 97845

(541)575-1813

cornerstonesurvey@centurytel.net

LEGEND

Application No. R-47274

Permit No. R-7901

Priority 6/8/1961

A portion of Tax Lot
23-36 TL100

NOTE: Tax Lot 100 is owned by the BLM
and is more that 22,000 acres.
Therefore only a portion of the tax
lot boundary can be shown.

NOTE: The preparation of this map
was for the purpose of identifying
the location of the proposed water
right and has no intent to provide
dimensions or location of property
ownership lines.

RECEIVED BY OWRD

NOV 03 2017

SALEM, OR

