


854


Sections 27, 28, 33 & 34, T7S, R44E, W.M.,
Baker County, Oregon

Application R-72115, Permit R-12240
CLAIM OF BENEFICIAL USE MAP
Hideaway Hills, Inc.

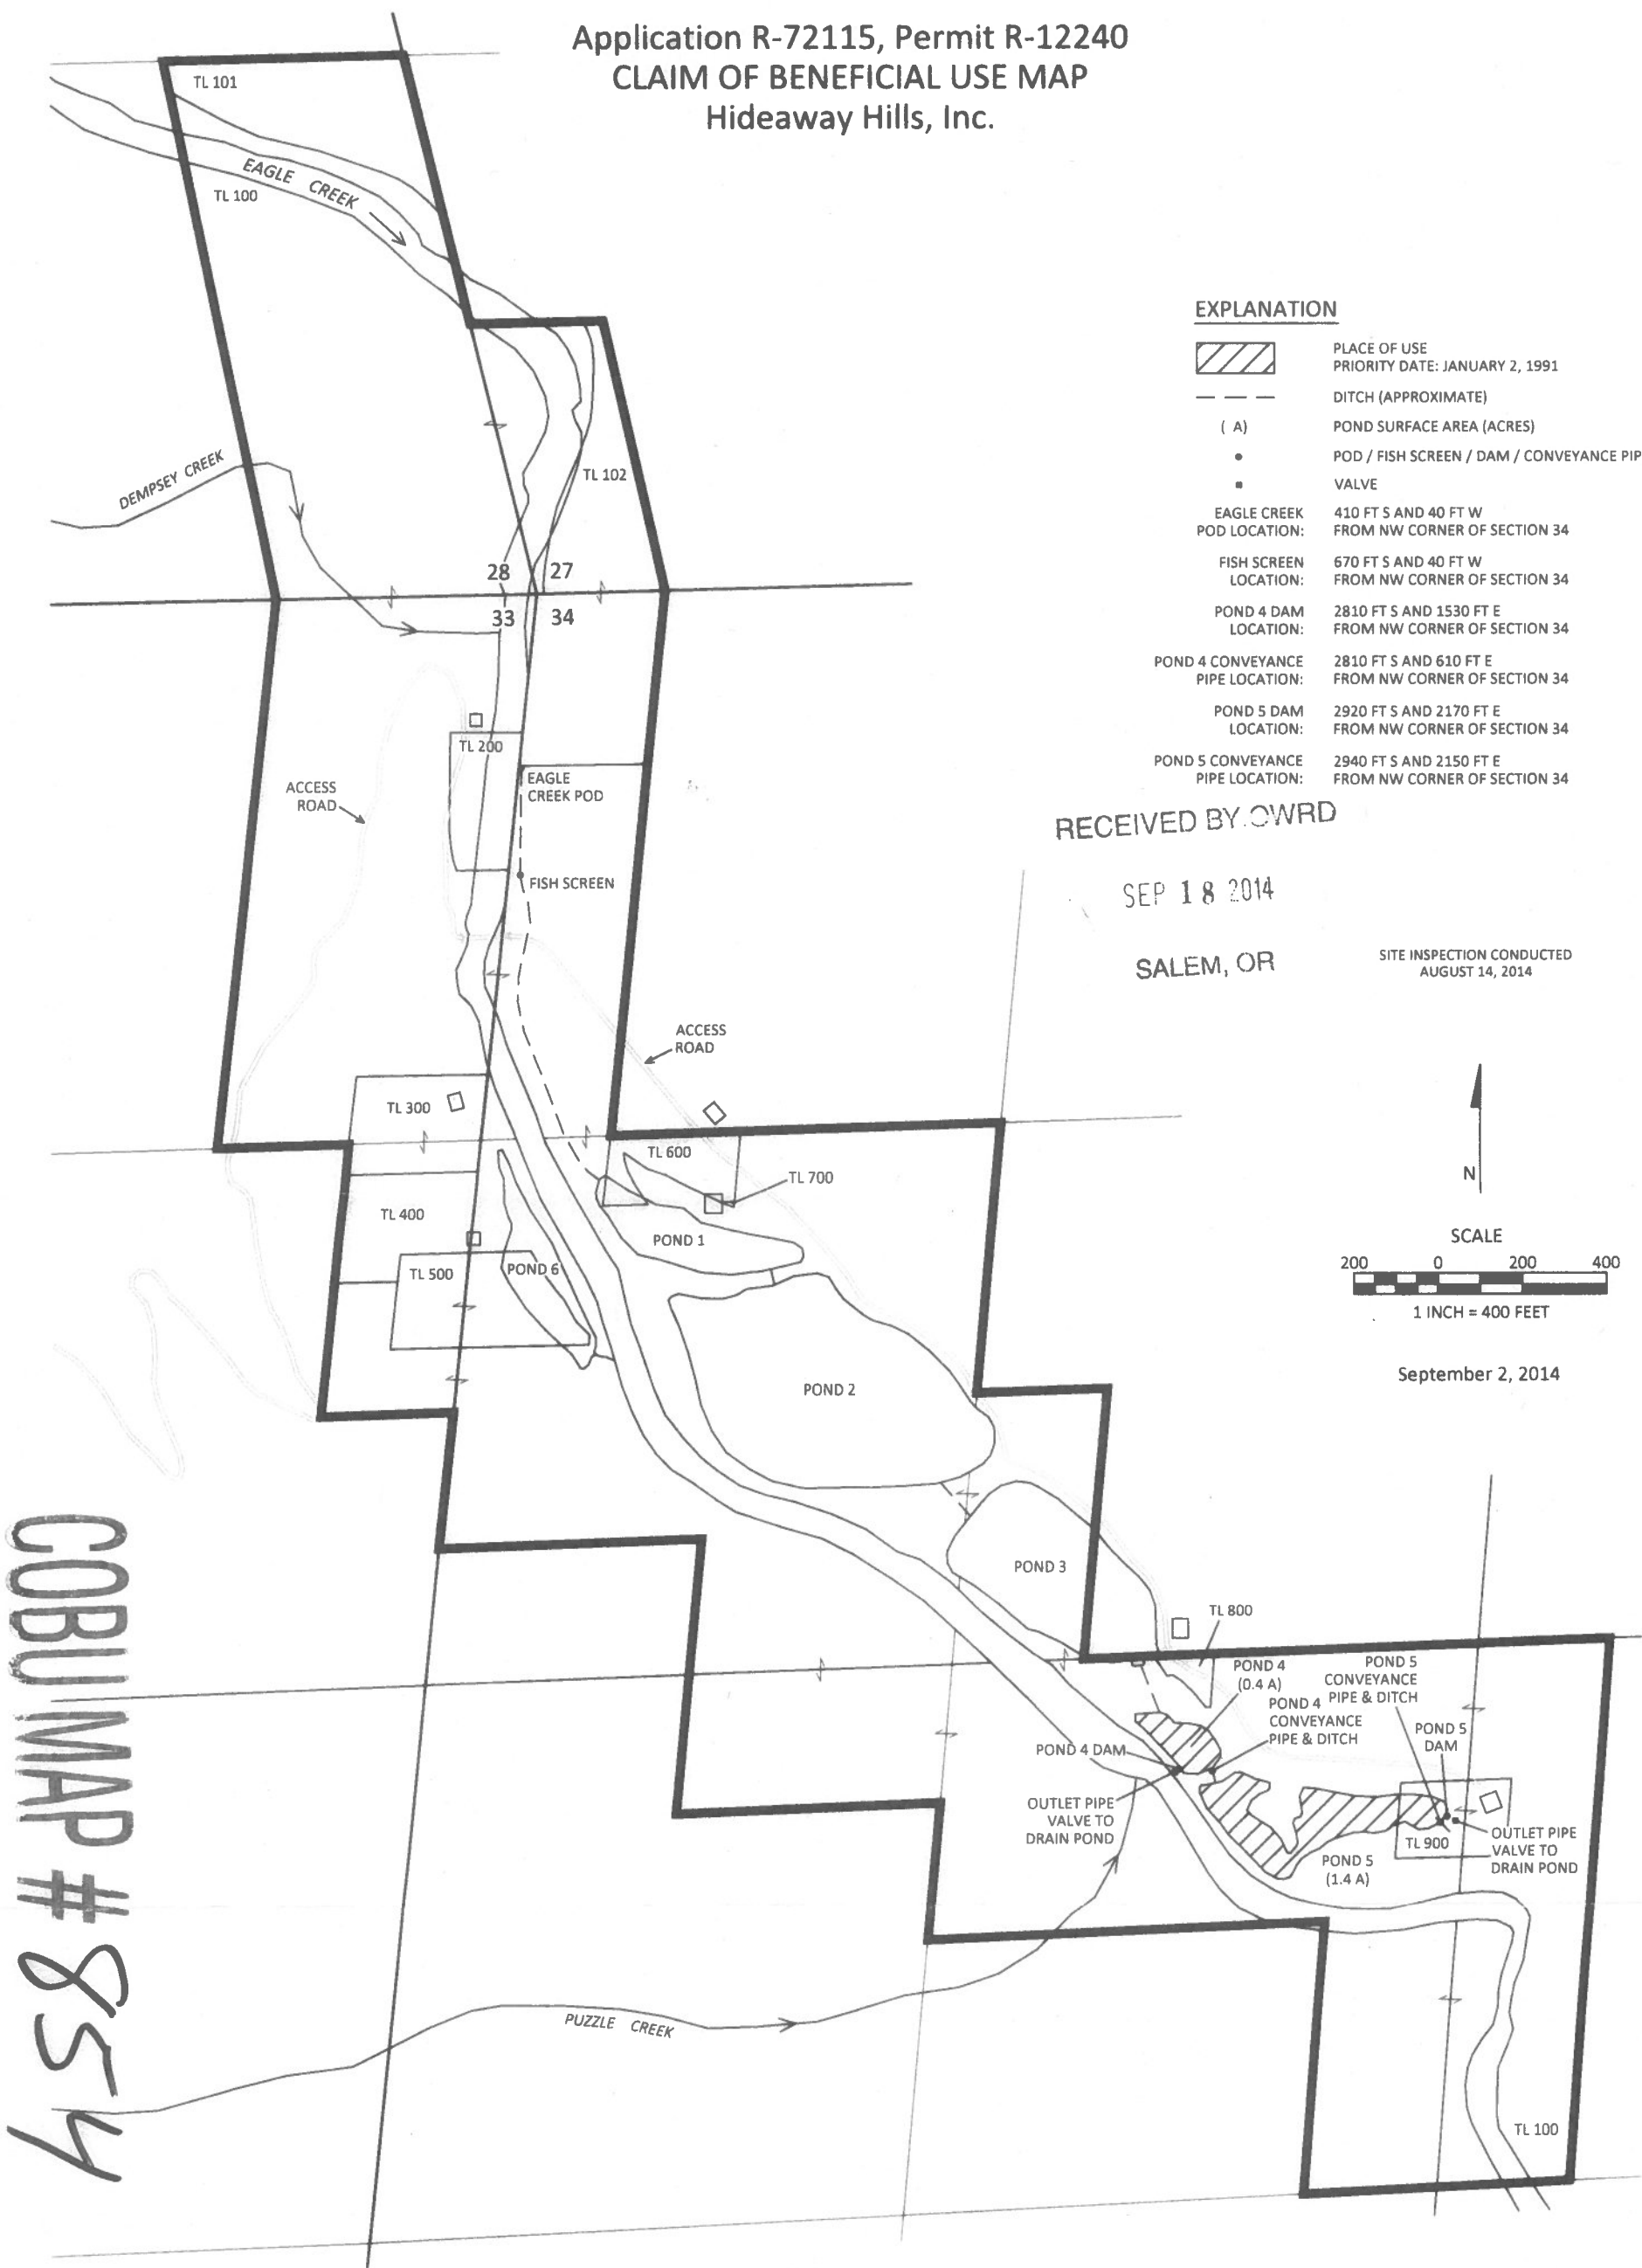

COBU MAP # 854

SKOOKUM
WATER ASSOCIATES INC
P.O. BOX 80174
PORTLAND, OR 97280
(503) 319-8926

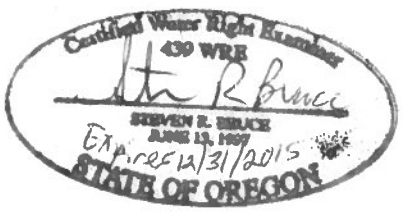

This map is not intended to provide legal
dimensions or locations of property
ownership lines

Figure 1