

CLAIM OF BENEFICIAL USE FOR S. PAUL SMITH


LOCATED IN SE 1/4 OF SW 1/4, SECTION 20
T. 35 S., R. 14 W., W. M., CURRY COUNTY, OR

APPLICATION NO. 80734

PERMIT NO. 53363

1" = 400'

OCTOBER 2014

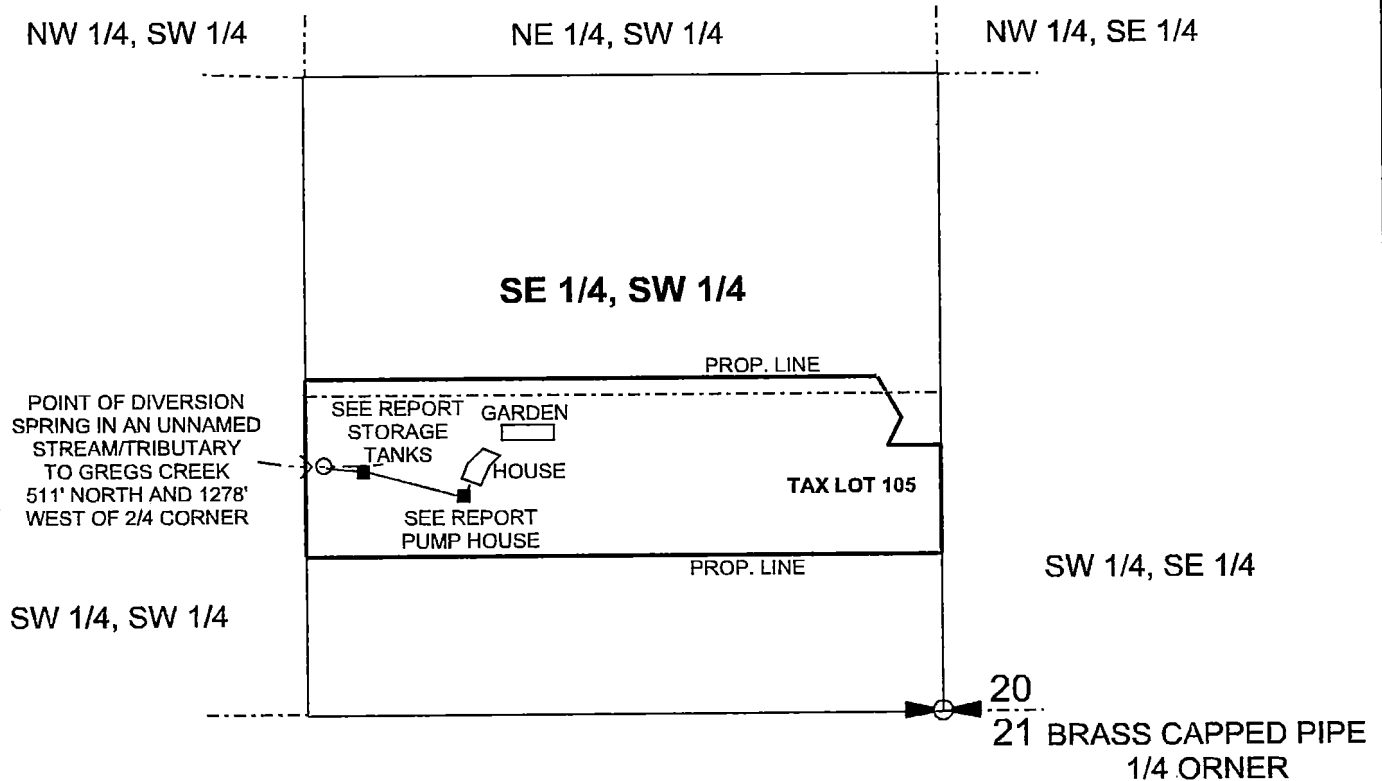


RECEIVED BY OWRD

10-18-2014

SALEM, OR

The preparation of this map is for the purpose of identifying the location of the water right and it's relation to the property and has no intent to provide dimensions or loction of property lines.

FLAVIN LAND SURVEYING
32053 CEDAR VALLEY ROAD
GOLD BEACH, OREGON
97444
541-247-6485
541-425-0615
C.W.R.E. #366

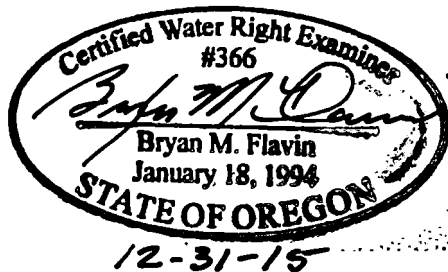

S. PAUL SMITH
P. O. BOX 99
OPHIR, OR
97464