


# T.4S. R.3E. Section 17, W.M.

7 | 8

18 | 17



Well (CLAC 19833) is located 2,400 feet south and 1,125 feet east from the NW corner, Section 17.


 Area (13.0 Acres) of primary irrigation and agricultural use under Application G-13969, Permit G-12515.

----- Tax lot boundary

..... Water main line

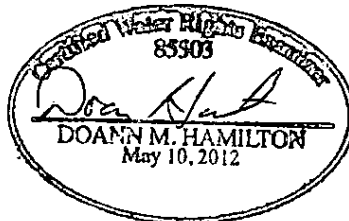

REVISED JUN 30 2019

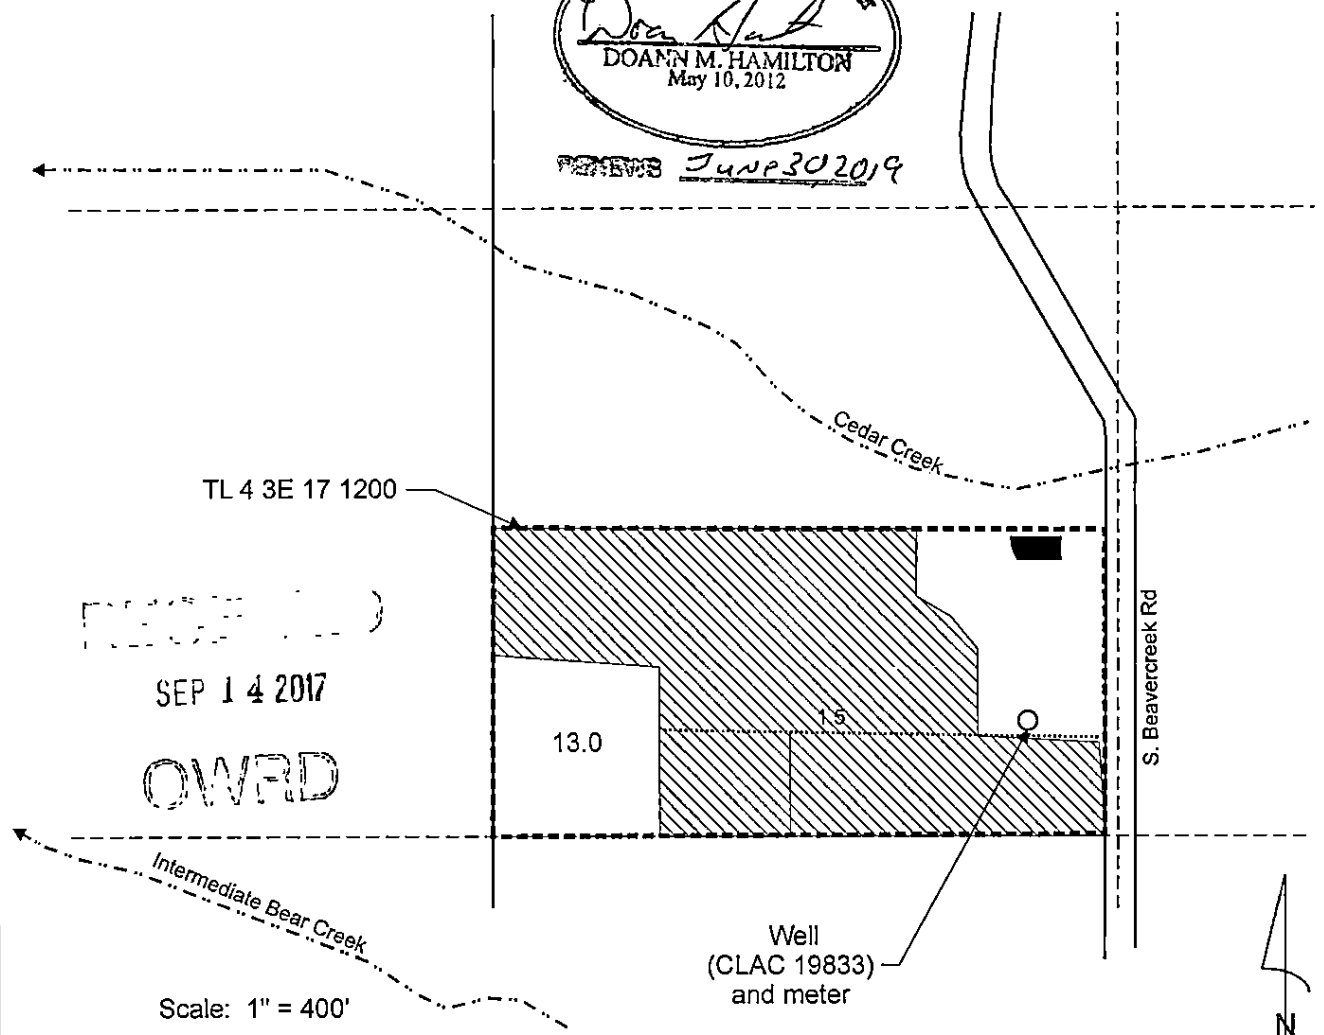

TL 4 3E 17 1200


RECEIVED  
SEP 14 2017  
OWRD

13.0

1.5

Well  
(CLAC 19833)  
and meter

Scale: 1" = 400'

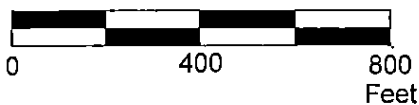

This map was prepared for the purpose of identifying the location of a water right only and is not intended to provide legal dimensions or location of property ownership lines.

Claim of Beneficial Use Map  
Application G-13969, Permit G-12515

Patrick Whitmore  
T.4S. R.3E. Section 17, W.M.

Pacific Hydro-Geology Inc.

07/2017

WhitmoreCOBU.cdr