


EXHIBIT B

T33S, R32E, W.M.
Harney County, Oregon

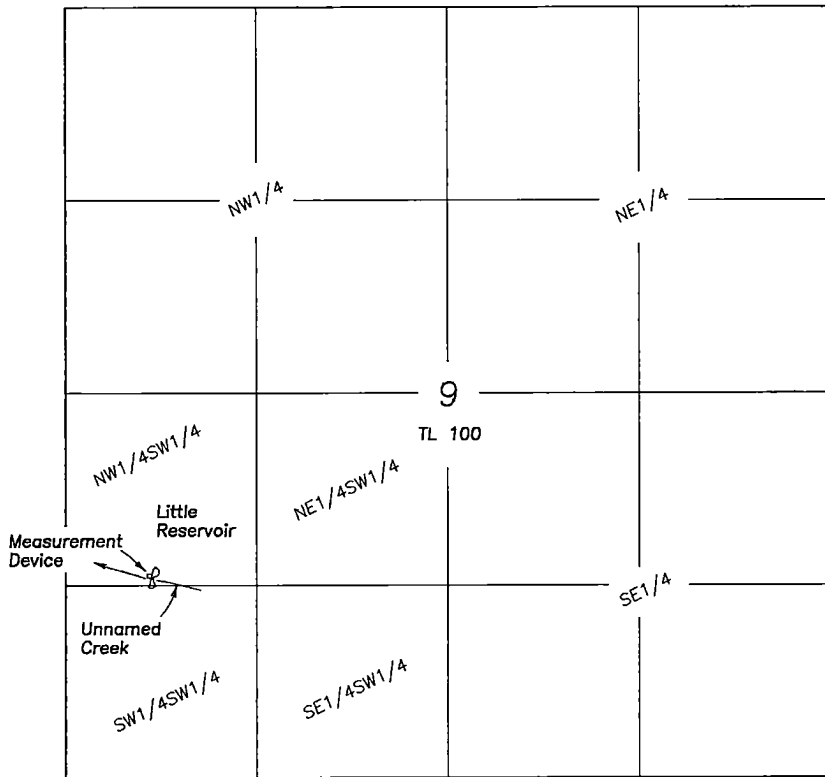

SCALE 1"=1320'

Outlet is located 1300' North & 570' East of the
SW corner of Section 9.

Measuring device is located 80' North and 15' East of the Outlet.

FINAL PROOF SURVEY
CLAIM OF BENEFICIAL USE
LITTLE RESERVOIR

For

Bureau of Land Management

July 11, 2017

Prepared by

Cornerstone Surveying, Inc

P.O. BOX 33

JOHN DAY, OR. 97845

(541)575-1813

cornerstonesurvey@centurytel.net

LEGEND

Application No. R-59608

Permit No. R-8047

Priority 12/21/1979

A portion of Tax Lot
33-32 TL100

NOTE: Tax Lot 100 is owned by the BLM
and is more that 19,000 acres.
No boundaries of the tax lot
can be shown.

NOTE: The preparation of this map
was for the purpose of identifying
the location of the proposed water
right and has no intent to provide
dimensions or location of property
ownership lines.

RECEIVED BY OWRD

NOV 03 2017

SALEM, OR

