


EXHIBIT B

T23S, R36E, W.M.
Harney County, Oregon

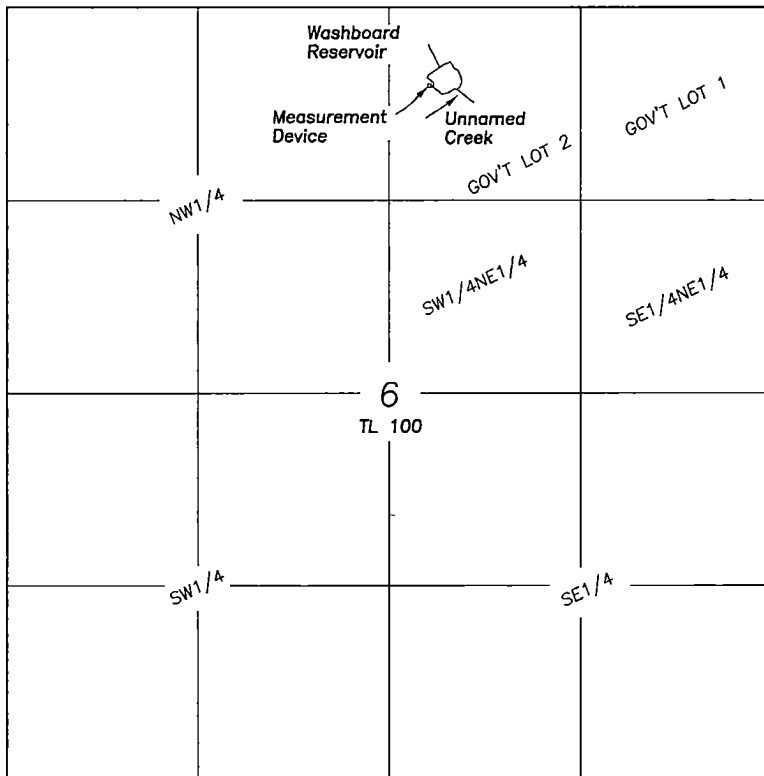

SCALE 1"=1320'

Outlet is located 530' South & 2340' West of the
NE corner of Section 6.

Measuring device is located 7' North of the outlet.

FINAL PROOF SURVEY
CLAIM OF BENEFICIAL USE
WASHBOARD RESERVOIR

For

Bureau of Land Management

September 15, 2017

LEGEND

Application No. R-47273

Permit No. R-7900

Priority 7/24/1970

A portion of Tax Lot
23-36 TL100

NOTE: Tax Lot 100 is owned by the BLM
and is more that 22,000 acres.
Therefore only a portion of the tax
lot boundary can be shown.

NOTE: The preparation of this map
was for the purpose of identifying
the location of the proposed water
right and has no intent to provide
dimensions or location of property
ownership lines.

RECEIVED BY OWRD

NOV 06 2017

SALEM, OR

Prepared by
Cornerstone Surveying, Inc

P.O. BOX 33

JOHN DAY, OR. 97845

(541)575-1813

cornerstonesurvey@centurytel.net

