


EXHIBIT B

T32S, R32.5E, W.M.
Harney County, Oregon

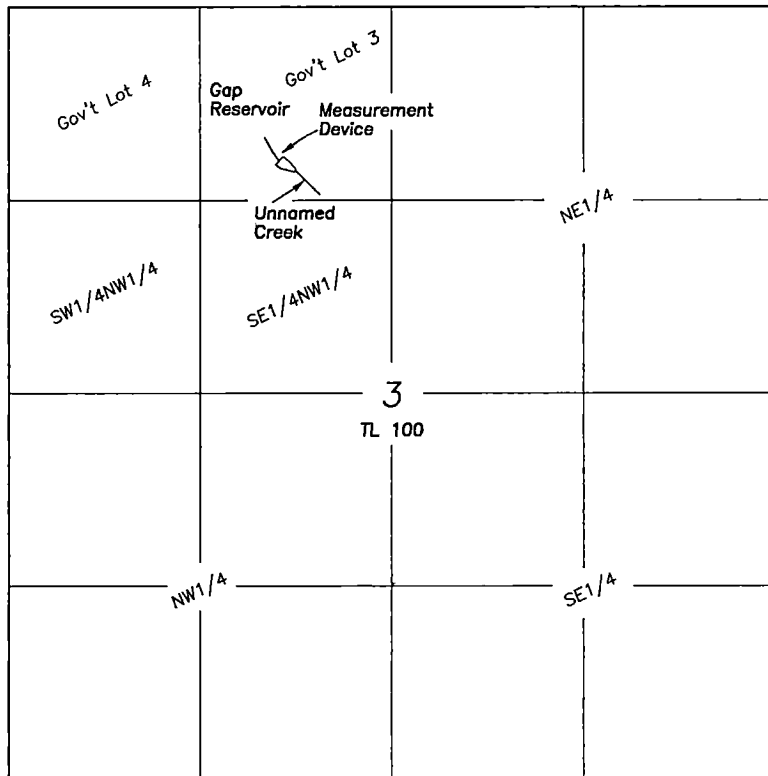

SCALE 1"=1320'

Outlet is located 1010' South & 1900' East of the
NW corner of Section 3.

Measuring device is located 10' West of the outlet

FINAL PROOF SURVEY
CLAIM OF BENEFICIAL USE
GAP RESERVOIR

For

Bureau of Land Management

September 18, 2017

LEGEND

Application No. R-85844

Permit No. R-13978

Priority 10/2/2003

A portion of Tax Lot
32-32.5 TL100

NOTE: Tax Lot 100 is owned by the BLM
and is more that 22,000 acres.
Therefore only a portion of the tax
lot boundary can be shown.

Prepared by
Cornerstone Surveying, Inc

P.O. BOX 33
JOHN DAY, OR. 97845
(541)575-1813

cornerstonesurvey@centurytel.net

NOTE: The preparation of this map
was for the purpose of identifying
the location of the proposed water
right and has no intent to provide
dimensions or location of property
ownership lines.

RECEIVED BY OWRD

NOV 03 2017

SALEM, OR

