


EXHIBIT B

T30S, R33E, W.M.
Harney County, Oregon

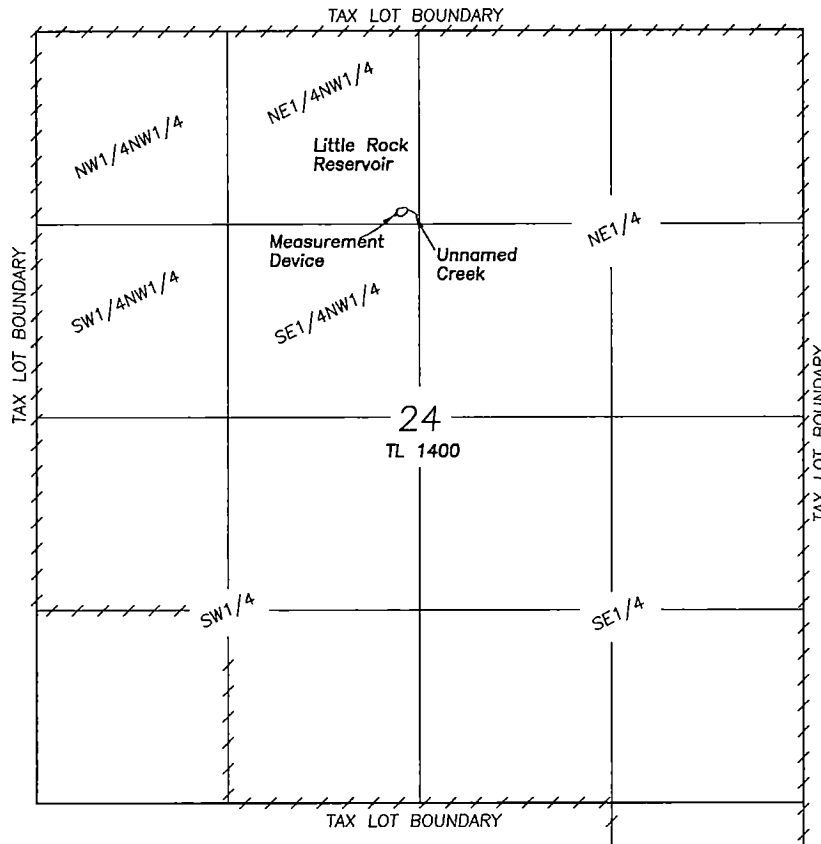

SCALE 1"=1320'

Outlet is located 1260' South & 2800' West of the
NE corner of Section 24.

Measuring device is located 6' North of the outlet

FINAL PROOF SURVEY
CLAIM OF BENEFICIAL USE
LITTLE ROCK RESERVOIR

For

Bureau of Land Management

September 12, 2017

LEGEND

Application No. R-66483

Permit No. R-11095

Priority 1/16/1985

--- Tax Lot Boundary

A portion of Tax Lot

30-33 TL1400

NOTE: Tax Lot 1400 is owned by the BLM
and is more than 640 acres.

Only a portion of the tax
lot boundary is shown.

Prepared by
Cornerstone Surveying, Inc

P.O. BOX 33

JOHN DAY, OR. 97845

(541)575-1813

cornerstonesurvey@centurytel.net

NOTE: The preparation of this map
was for the purpose of identifying
the location of the proposed water
right and has no intent to provide
dimensions or location of property
ownership lines.

RECEIVED BY OWRD

NOV 03 2017

SALEM, OR

