



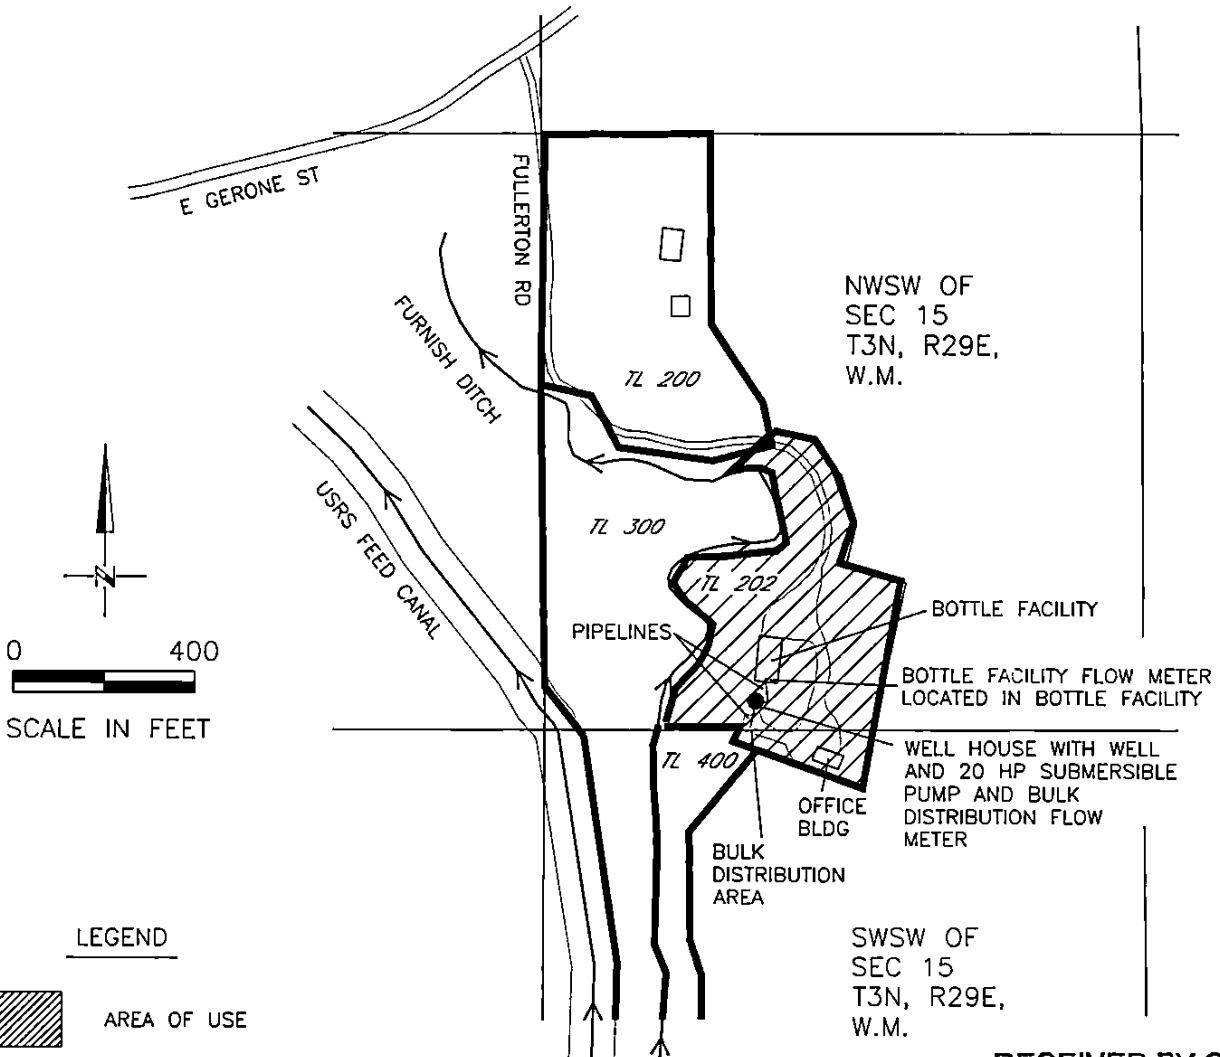

CLAIM OF BENEFICIAL USE MAP  
 FOR TRANSFER 10548  
 DESERT SPRINGS BOTTLED WATER CO  
 SEC 15, T3N, R29E W.M., UMATILLA COUNTY

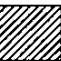

- LEGEND**
-  AREA OF USE
  -  POA  
WELL LOCATED 1370'N  
AND 475'E FROM THE  
SW CORNER OF SEC 15,  
T3N, R29E, W.M.
  -  TAX 'LOT  
BOUNDARY


NWSW OF  
 SEC 15  
 T3N, R29E,  
 W.M.

SWSW OF  
 SEC 15  
 T3N, R29E,  
 W.M.

RECEIVED BY OWRD

AUG 11 2017

SALEM, OR

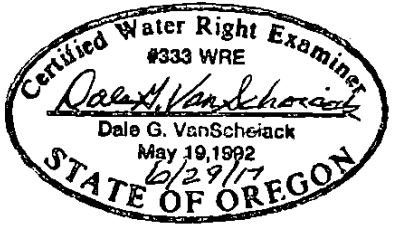

Renew  
 6/30/18

DGV Consulting, PLLC  
 PHONE (509) 627-8717  
 dalevconsulting@gmail.com  
 Date: June 29, 2017

NOTE:  
 THE PURPOSE OF THIS MAP IS TO IDENTIFY THE APPROXIMATE LOCATION OF THE WATER  
 RIGHT. IT IS NOT INTENDED TO PROVIDE INFORMATION RELATIVE TO THE LOCATION OF  
 PROPERTY OWNERSHIP BOUNDARY LINES. PIPELINE SIZES AND LOCATIONS WERE  
 PROVIDED BY THE PROPERTY OWNER PERSONNEL AND HAVE NOT BEEN VERIFIED.