


This map is not intended to provide legal dimensions or locations of property ownership lines

Township 17 S Range 3 East Section 2

WRD has updated this map to reflect the correct
QQ's for the location of place of use table to show
SW NE. JLS/WRD 2-22-18 *JS*

Township 17 South Range 3 East Section 2 Lane County
Tax Lots 17-35-02-10-01501 and 17-35-02-10-01502

Section	Tax Lot	1/4 1/4	Government Lot	DLC	Acreage
2	1501	SW-SW	NE 2		0.200
2	1502	SW-SW	NE 2		0.115
Total Acreage					0.315

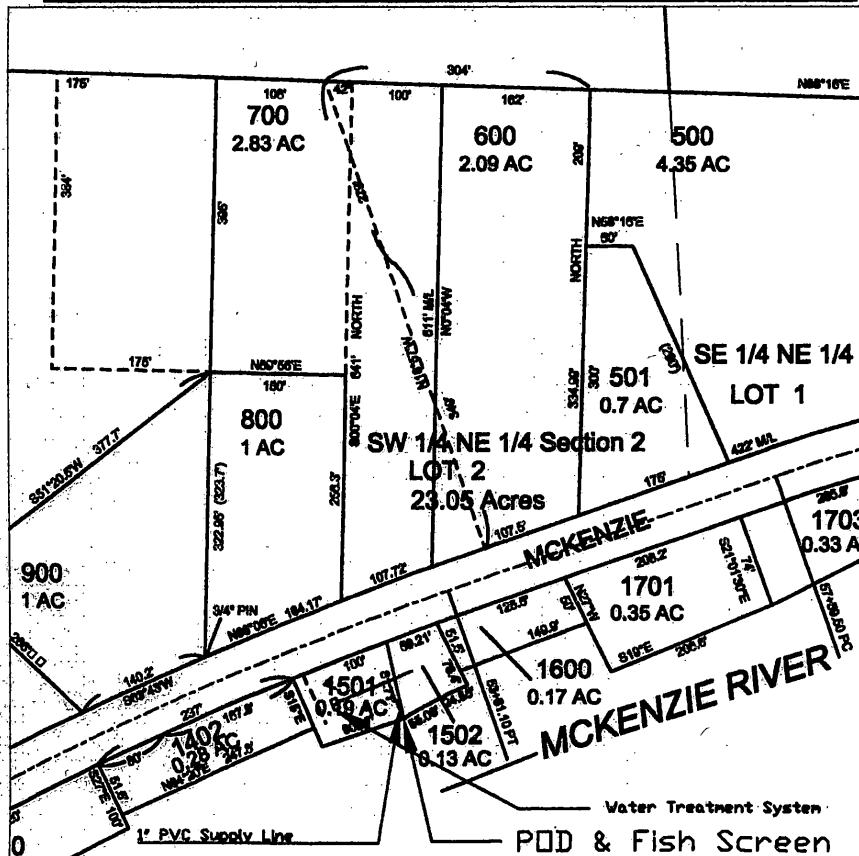

1 INCH = 400 FEET

1/4 1/4 SECTION LINES TAX LOT BOUNDARIES

POD 585 FEET NORTH
1680 FEET WEST FROM
EAST 1/4 CORNER OF
SECTION 2



EXPIRATION DATE: 12/31/14

FINAL PROOF SURVEY
PERMIT S-54403, APPLICATION S86678
Kent Winslow
COTTAGE GROVE, OREGON

EGR & Associates, Inc.

Engineers, Geologists, and Surveyors

2535B Prairie Road
Eugene, Oregon 97402

(541) 888-8322
Fax (541) 888-8087