
## T. 32 S., R. 6 W., W.M.

SCALE: 1" = 1000'

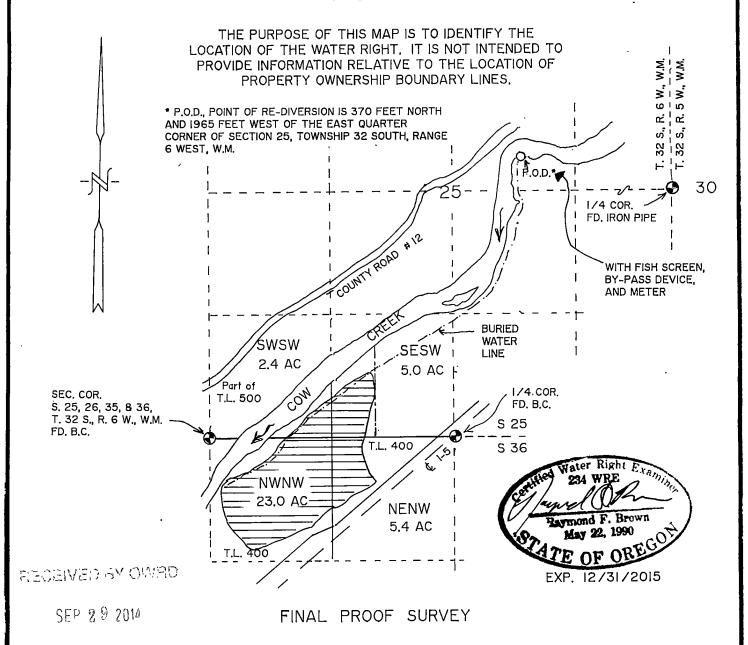

SALEM, OF

**UNDER** 

Application No. S-87613, Permit No. S-54668

RECEIVED BY OWRD

IN NAME OF

DEC 11 2017

ANDREW OWENS

SALEM, OR

Surveyed SEPT. 10, 2014, by R.F. BROWN