


EXHIBIT B

T23S, R35E, W.M.
Harney County, Oregon

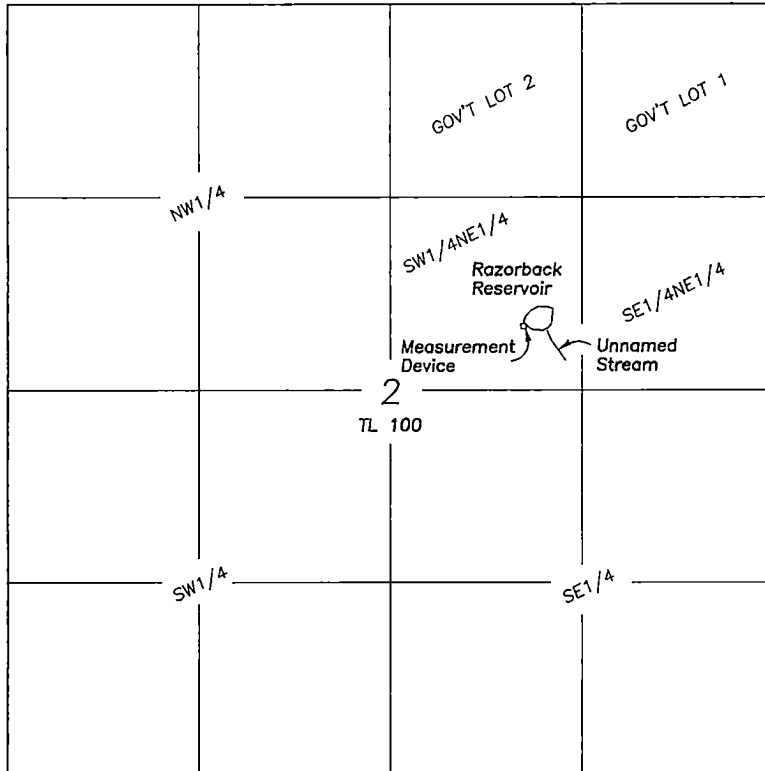

SCALE 1"=1320'

Outlet is located 2230' South & 1700' West of the
NE corner of Section 2.

Measuring device is located 10' North of the outlet

FINAL PROOF SURVEY
CLAIM OF BENEFICIAL USE
RAZORBACK RESERVOIR

For

Bureau of Land Management

September 18, 2017

LEGEND

Application No. R-47278

Permit No. R-7902

Priority 7/24/1970

A portion of Tax Lot
23-35 TL100

NOTE: Tax Lot 100 is owned by the BLM
and is more that 18,000 acres.
Therefore only a portion of the tax
lot boundary can be shown.

NOTE: The preparation of this map
was for the purpose of identifying
the location of the proposed water
right and has no intent to provide
dimensions or location of property
ownership lines.

RECEIVED BY OWRD

NOV 03 2017

SALEM, OR

Prepared by
Cornerstone Surveying, Inc

P.O. BOX 33
JOHN DAY, OR. 97845

(541)575-1813

cornerstonesurvey@centurytel.net

