


EXHIBIT B

T31S, R32.75E, W.M.
Harney County, Oregon

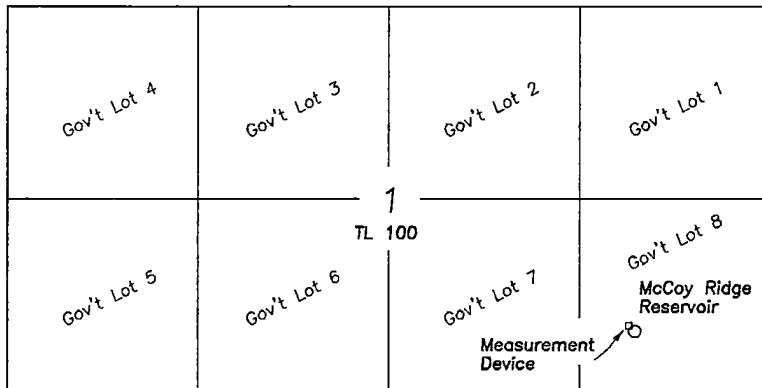

SCALE 1"=1320'

Outlet is located 430' North & 950' West of the
SE corner of Section 1.

Measuring device is located 12' South of the outlet

FINAL PROOF SURVEY CLAIM OF BENEFICIAL USE MCCOY RIDGE RESERVOIR

For

Bureau of Land Management

September 12, 2017

LEGEND

Application No. R-34902

Permit No. R-2758

Priority 6/8/1961

A portion of Tax Lot
31-32.75 TL100

NOTE: Tax Lot 100 is owned by the BLM
and is more that 17,000 acres.
Therefore only a portion of the tax
lot boundary can be shown.

Prepared by .

Cornerstone Surveying, Inc

P.O. BOX 33

JOHN DAY, OR. 97845

(541)575-1813

cornerstonesurvey@centurytel.net

NOTE: The preparation of this map
was for the purpose of identifying
the location of the proposed water
right and has no intent to provide
dimensions or location of property
ownership lines.

RECEIVED BY OWRD

NOV 03 2017

SALEM, OR

