


Claim of Beneficial Use Place of Use and Point of Diversion

Transfer T-12239
Crook County


Townships 16 & 17 South, Ranges 16, 17, & 18 East (W.M.)

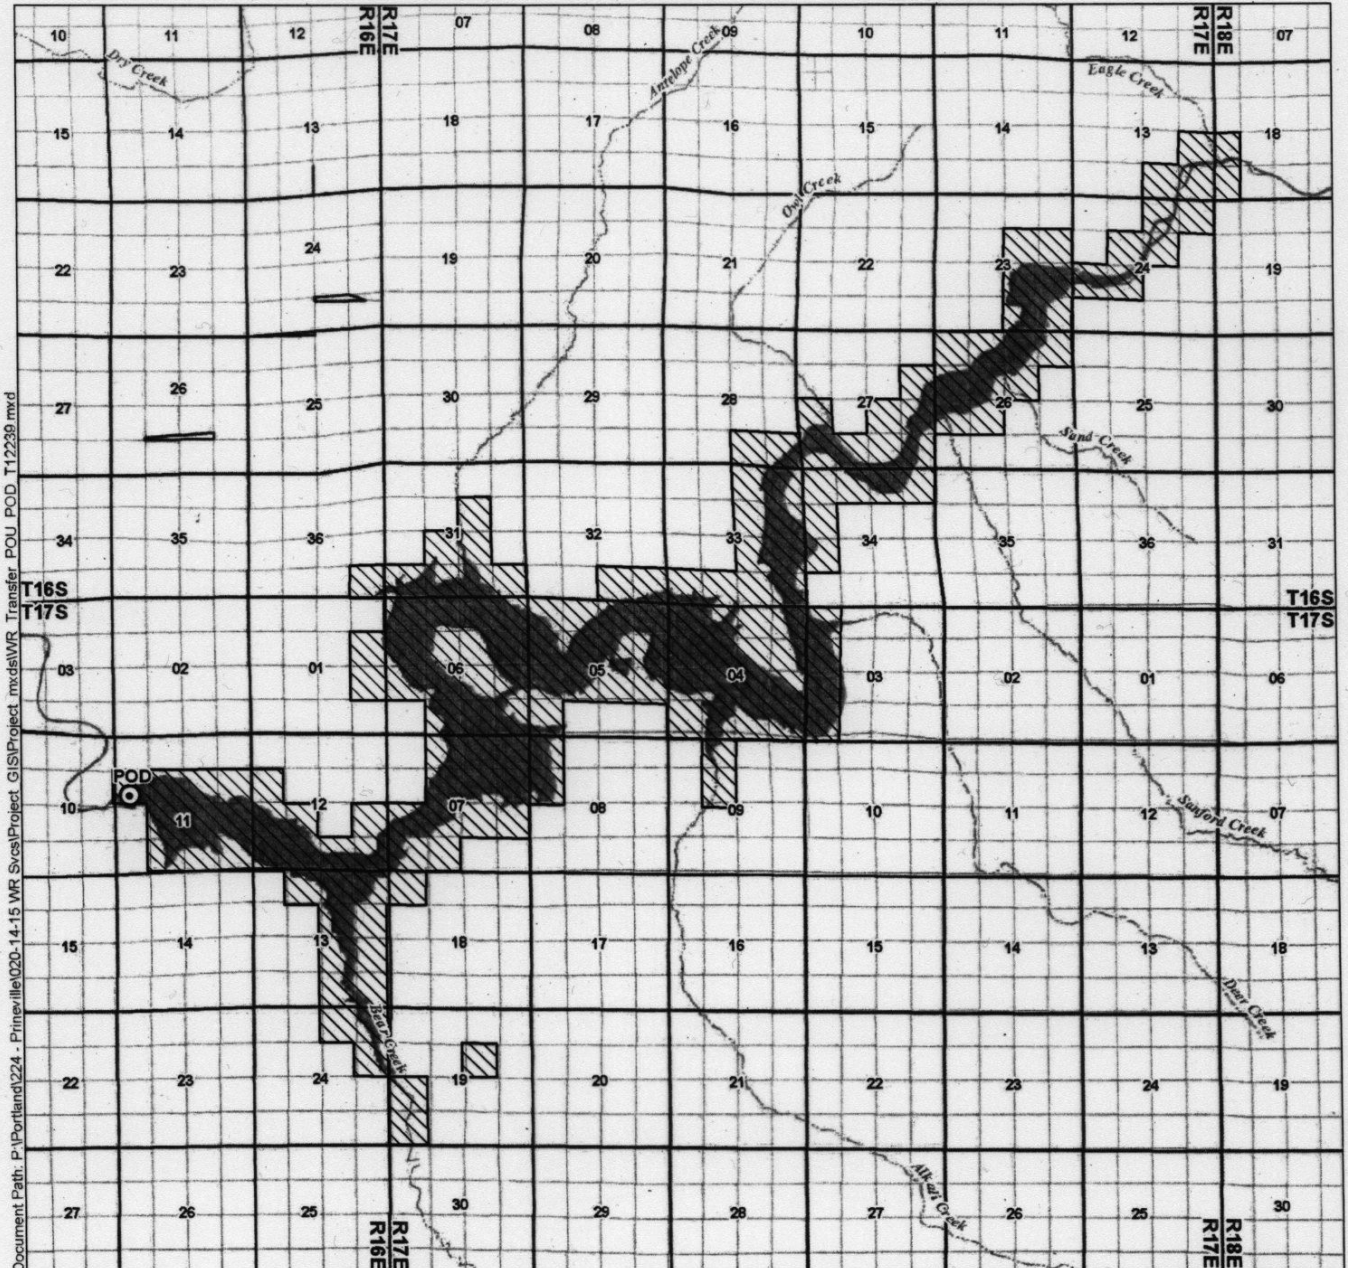

Document Path: P:\Portland\224 - Prineville\020-14-15 WR Svcs\Project_GIS\Project_mxd\WR_Transfer_POU_POD_T12239.mxd

- LEGEND**
- Point of Diversion (POD)
 - Place of Use (POU)
 - Highways
 - Watercourse
 - Waterbody

POD Location Description
 POD
 Located 2,350 feet South and 850 feet East from the NW Corner
 of Section 11, Township 17 South, Range 16 East (W.M.)

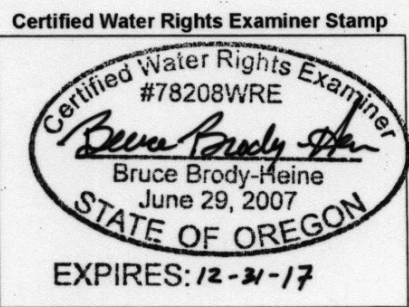

DISCLAIMER
 This map was prepared for the purpose of identifying the location of a water right only and it is not intended to provide legal dimensions or location of property ownership lines.

MAP NOTES
 Date: August 21, 2017
 Data Sources: OWRD, Crook Co. GIS, OGIC
 Prepared By: GSI Water Solutions, Inc.

