1112

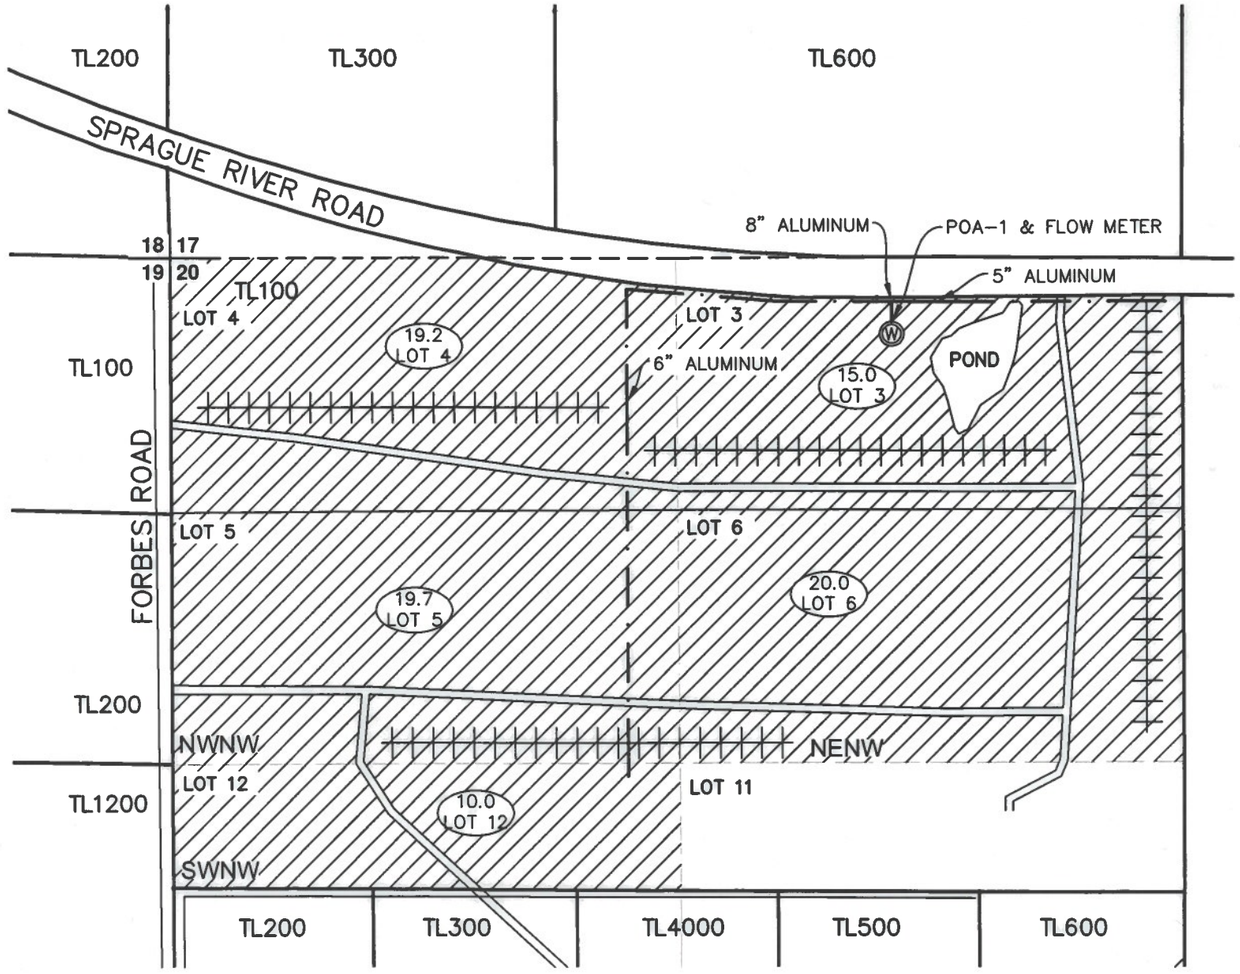

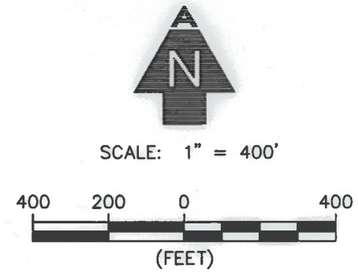

LEGEND

	SECTION LINE
	1/4 1/4 LINE
	TAX LOT LINE
	LOT LINE
	ABOVE GROUND PIPE
	ROAD
	WHEEL LINE
TL000	TAX LOT NUMBER
W	POA-1 (WELL) AND FLOW METER
18 17 / 19 20	SECTION CORNER
	IRRIGATED ACRES
19.2 LOT 4	IRRIGATED ACRES / GOVERNMENT LOT NUMBER
LOT 4	GOVERNMENT LOT NUMBER
NENW	1/4 1/4

COBU MAP# 1112

NOTES

1. THIS MAP WAS PREPARED FROM FIELD MEASUREMENTS, KLAMATH COUNTY TAX MAPS T36S, R11E, SEC. 20 AND GOOGLE AERIAL 2016.
2. DATE OF PRIORITY FOR THIS APPLICATION IS SEPTEMBER 20, 2004.
3. TOTAL PRIMARY IRRIGATED ACRES IS 83.9 ACRES.
4. WELL IS LOCATED IN THE NE 1/4 NW 1/4, 200 FEET SOUTH AND 1900 FEET WEST FROM SW CORNER, SECTION 20.

ADKINS
CONSULTING ENGINEERING, LLP
Engineers ▲ Planners ▲ Surveyors
1435 Esplanade Ave · Klamath Falls, Oregon 97601 · (541) 884-4666 · FAX (541) 884-5335
Oregon · California

2/7/2018 3467-01

CERTIFIED WATER RIGHT EXAMINER
#88332CWRE
Daniel B. Scalas
April 23, 2015
STATE OF OREGON
RENEWAL 06/30/18

RECEIVED
FEB 12 2018
OWRD

CLAIM OF BENIFICIAL USE MAP
FOR
CHRISTOPHER SMITH
T36S, R11E, SEC. 20, W.M.
KLAMATH COUNTY, OREGON
APPLICATION NUMBER: G-16314
PERMIT NUMBER: G-15947