
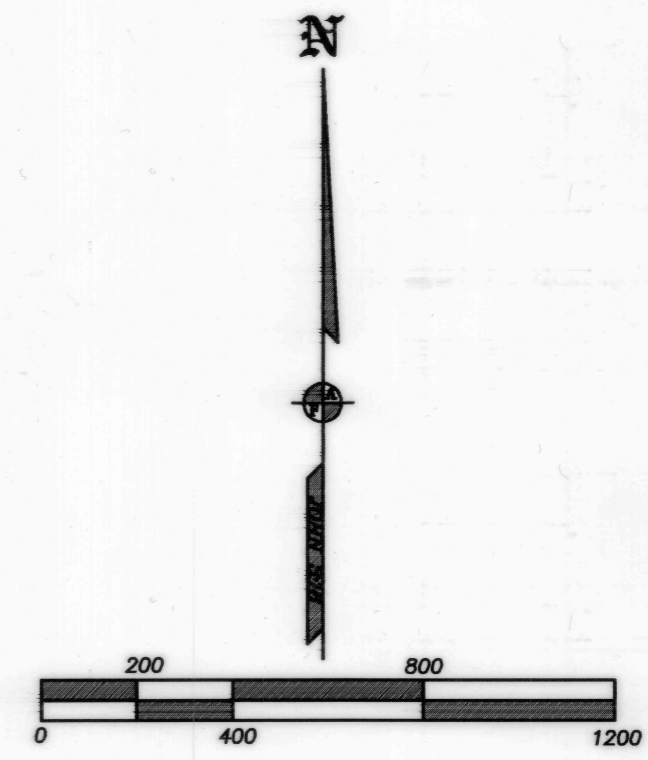


FINAL PROOF MAP
UNDER APPLICATION T-11881

29 28 27
32 33 34

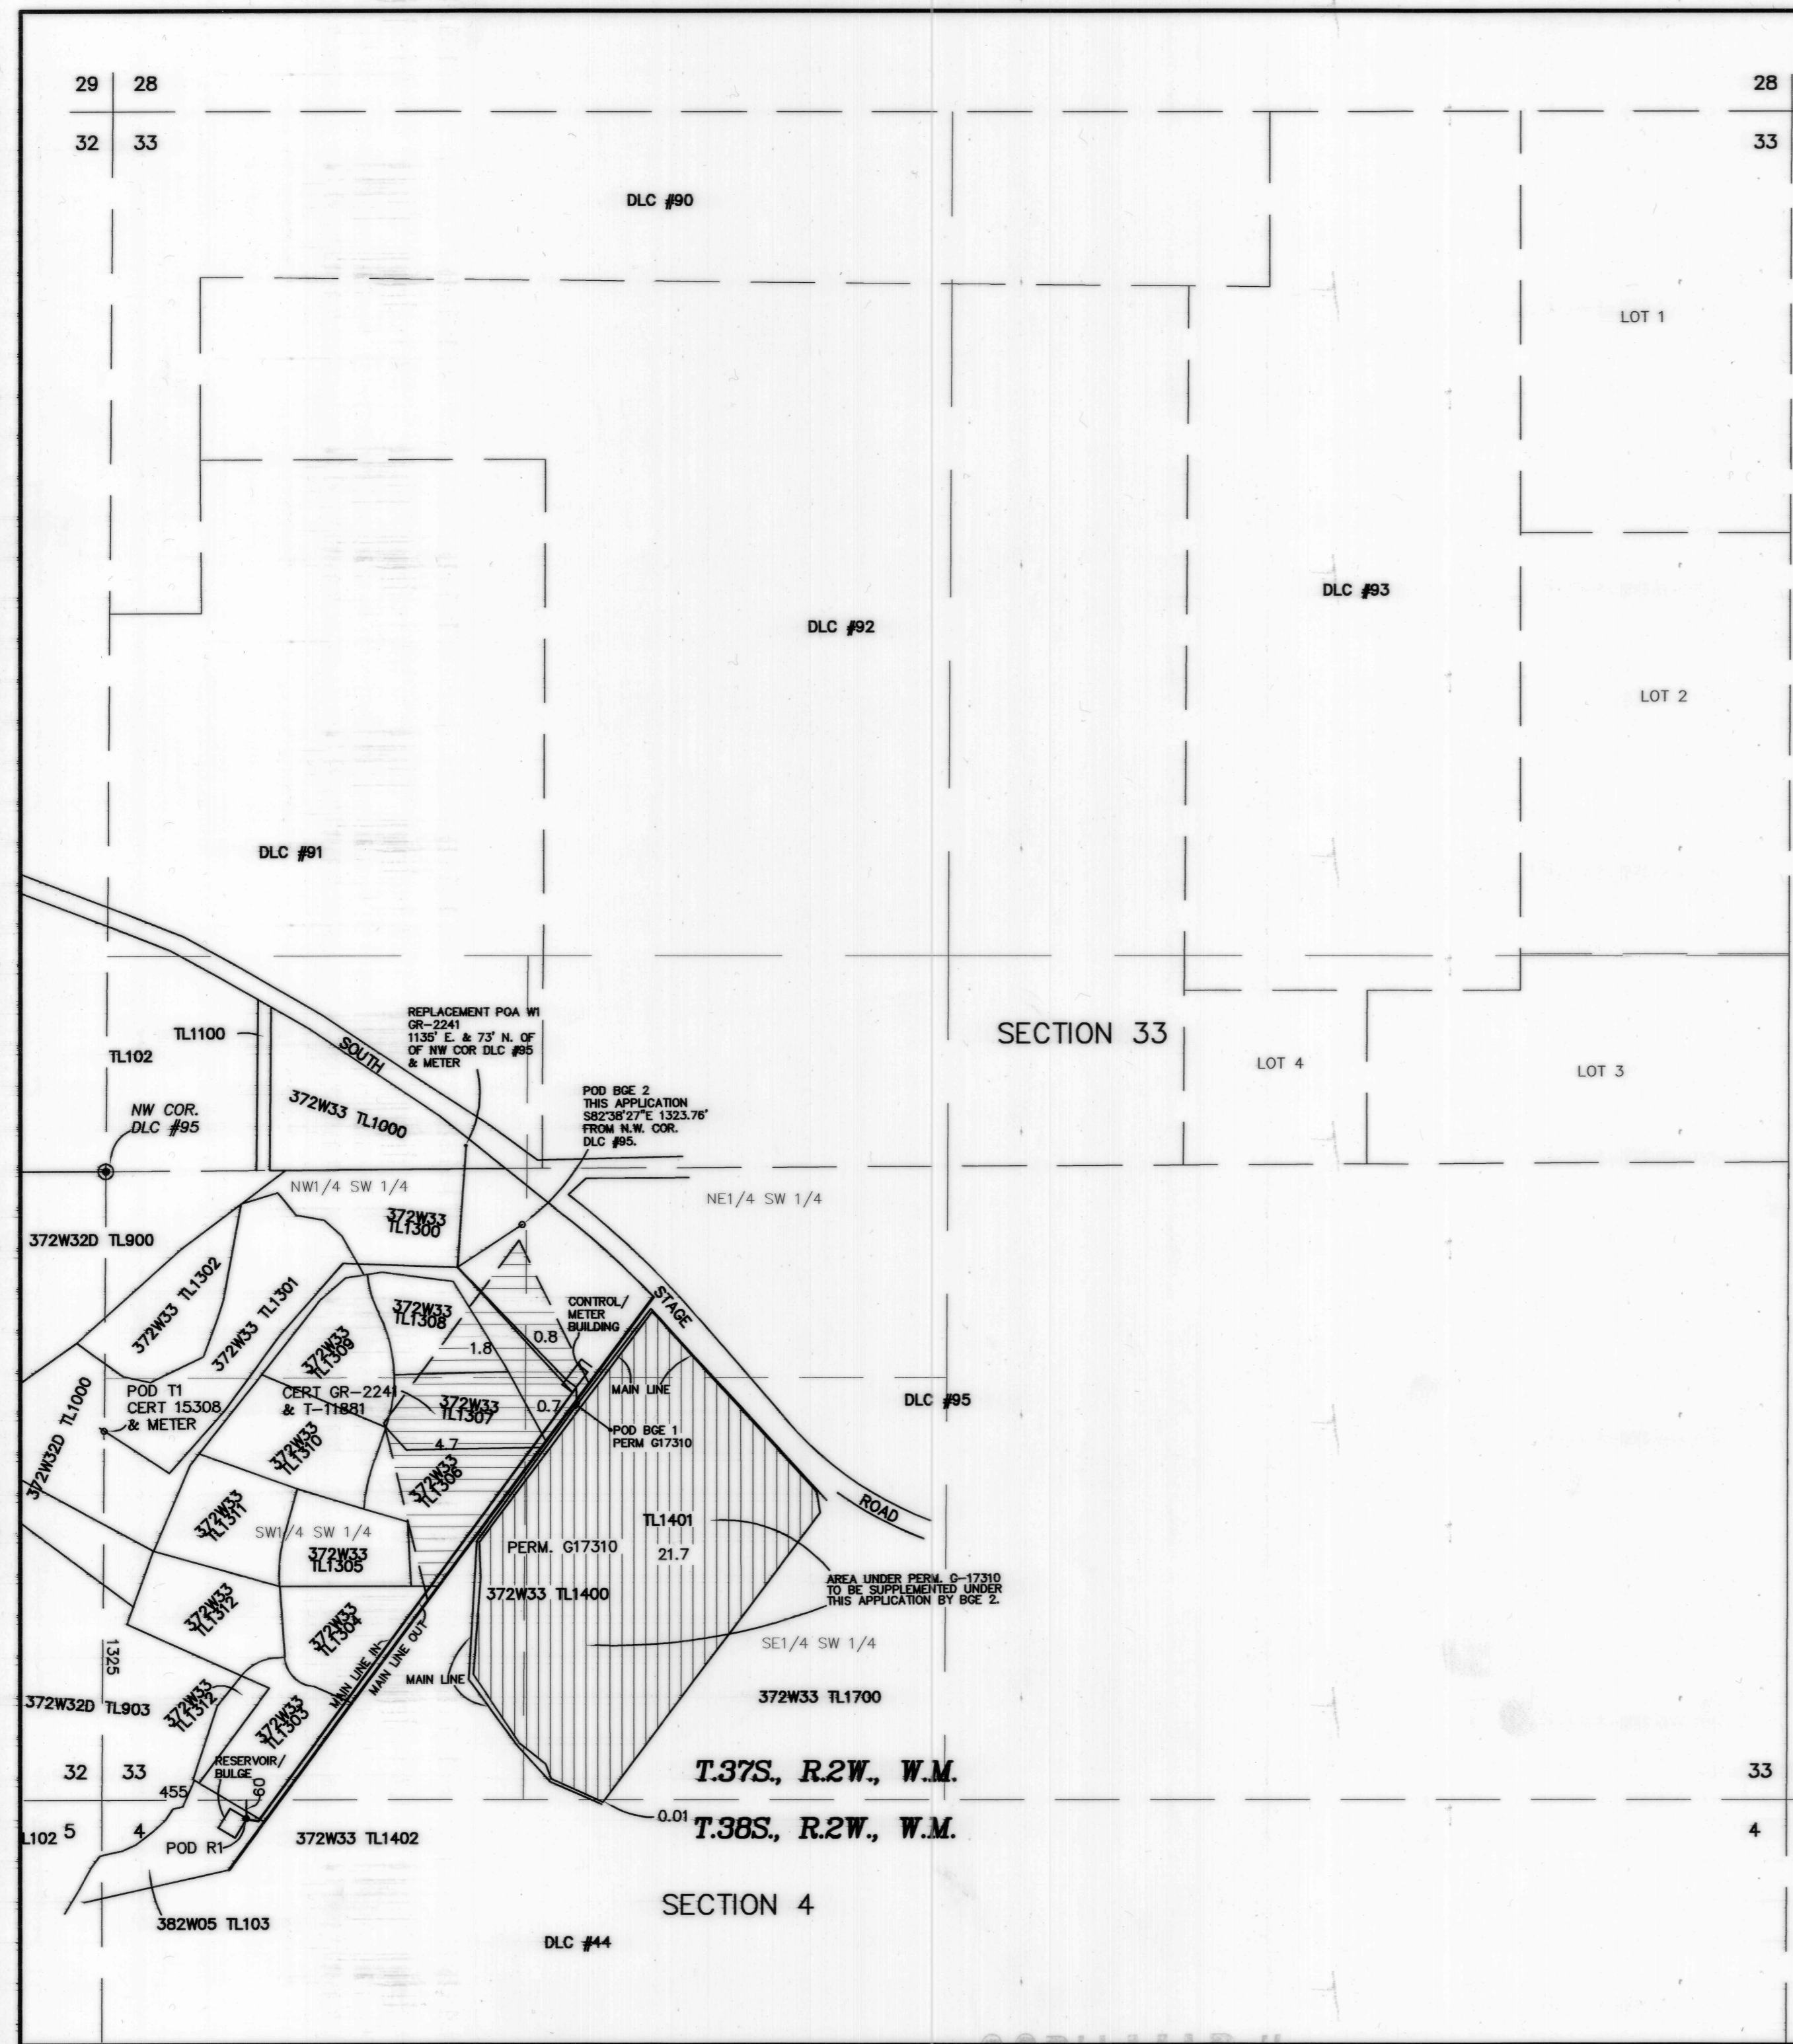

RECEIVED
MAR 01 2018
OWRD

RECEIVED
MAR 01 2018
OWRD

THE PREPARATION OF THIS MAP IS TO IDENTIFY THE WATER RIGHT ONLY AND IS NOT INTENDED TO PROVIDE LEGAL DIMENSIONS OF PROPERTY OWNERSHIP LINES.

	TITLE: FINAL PROOF MAP UNDER PERMIT T-11881 ASSESSOR'S MAP #: 372W33 TL1300 382W05 TL100	DATE: 23 FEB 2018 SCALE: 1 inch = 400 feet
	FOR: MARTIN FARMS PROPERTIES LLC PO BOX 3187 CENTRAL POINT, OR 97502	DRAWN BY: JEH CHK BY: ORIGIN:
	L.J. FRIAR & ASSOCIATES P.C. CONSULTING LAND SURVEYORS P.O. Box 1947, Phoenix, OR 97535 Phone: (541) 772-2782 Email: lfriar@charter.net	ROTATION: 0° JOB#: 14115FM Sheet 1 of 1.

COBU MAP# 1113

COBU MAP# 1113