


Claim of Beneficial Use Map

Transfer T-11623 (Willow Creek, Gilliam & Morrow Counties (F) Decree)
Water Right in the Name of Jerry R and Patricia J Nance


Township 3 South, Range 25 East, Section 16 (W.M.)

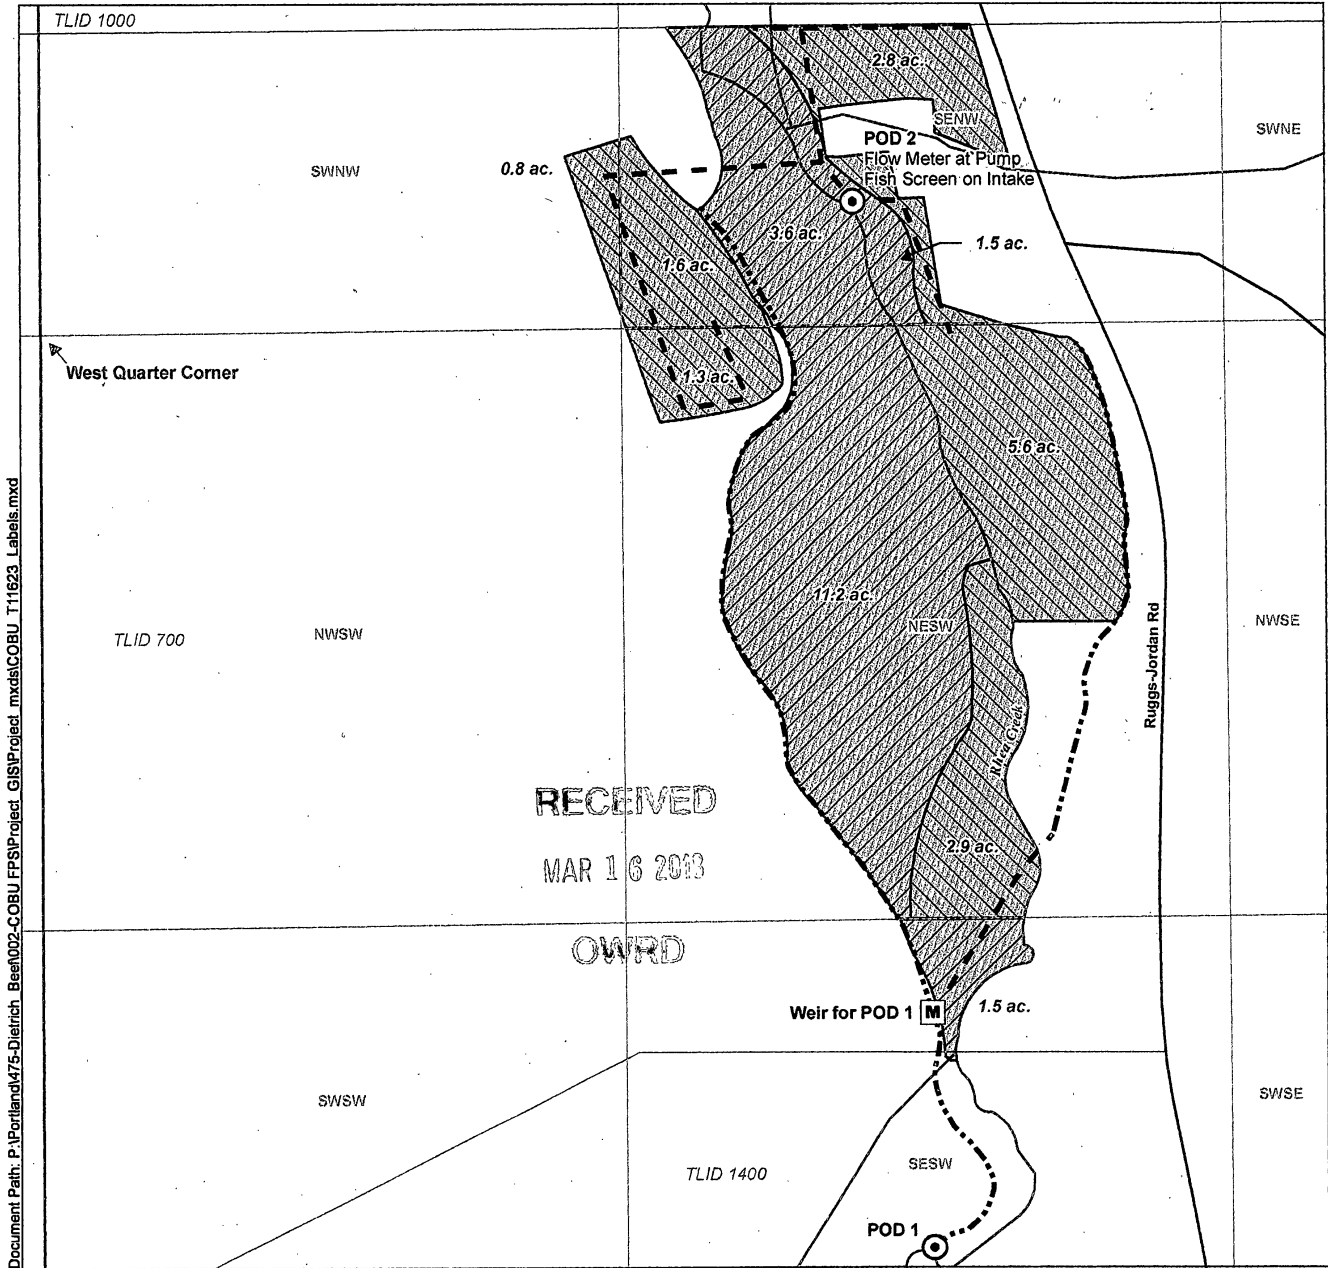

Document Path: P:\Portland\75-Dietrich_Beech\002-COBU FPS\Project_GSI\Project_mxd\COBU_T11623_Labels.mxd

- LEGEND**
- Point of Diversion (POD)
 - Place of Use, 1874 Priority Date
 - Place of Use, 1879 Priority Date
 - Mainline
 - Irrigation Ditch
 - Tax Lot
 - Road
 - Watercourse
 - Waterbody

POD Location Description
POD 1 Located 2,050 feet South and 1,975 feet East from the West quarter corner of Section 16, Township 3 South, Range 25 East (W.M.)
POD 2 Located 275 feet North and 1,805 feet East from the West quarter corner of Section 16, Township 3 South, Range 25 East (W.M.)

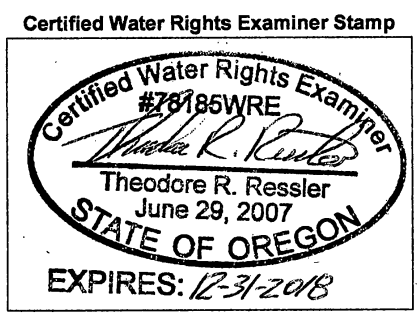

Disclaimer
 This map was prepared for the purpose of identifying the location of a water right only and it is not intended to provide legal dimensions or location of property ownership lines.

Map Notes
 Date: November 24, 2014
 Data Sources: BLM, OWRD
 Prepared By: GSI Water Solutions, Inc.

